


2111101 MW-2

1 LOCATION OF WATER WELL: County: <u>Osborne</u>	Fraction <u>SE 1/4 SE 1/4 NE 1/4</u>	Section Number <u>28</u>	Township Number T <u>6</u> S	Range Number R <u>11</u> E <u>(M)</u>
---	---	-----------------------------	---------------------------------	--

Distance and direction from nearest town or city street address of well, if located within city?
SE Cor. of Playground, W. of former Hedleys Cleaners (N of int. of Morgan & Railroad St.)

2 WATER WELL OWNER: RR#, St. Address, Box # : City, State, ZIP Code	<u>City of Downs</u> <u>715 Railroad</u> <u>Downs, KS 67437</u>	Board of Agriculture, Division of Water Resources Application Number:
---	---	--

3 LOCATE WELL'S LOCATION WITH AN "X" IN SECTION BOX:

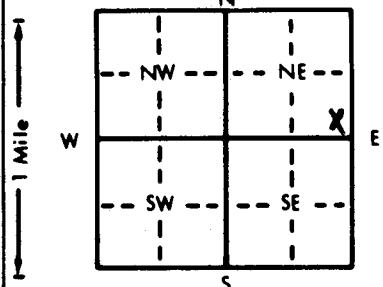

4 DEPTH OF COMPLETED WELL: <u>44'</u> ft.	ELEVATION: <u>148.00</u> ft.
Depth(s) Groundwater Encountered 1. ft. 2. ft. 3. ft.	
WELL'S STATIC WATER LEVEL <u>18.62</u> ft. below <u>Top</u> land surface measured on mo/day/yr <u>2-16-94</u>	
Pump test data: Well water was ft. after hours pumping gpm	
Est. Yield gpm: Well water was ft. after hours pumping gpm	
Bore Hole Diameter <u>8</u> in. to ft., and in. to ft.	
WELL WATER TO BE USED AS:	
5 Public water supply	8 Air conditioning
11 Injection well	12 Other (Specify below)
1 Domestic	3 Feedlot
6 Oil field water supply	9 Dewatering
2 Irrigation	4 Industrial
7 Lawn and garden only	10 Monitoring well
Was a chemical/bacteriological sample submitted to Department? Yes No <u>X</u>; If yes, mo/day/yr sample was submitted	
Water Well Disinfected? Yes No <u>X</u>	

5 TYPE OF BLANK CASING USED:	5 Wrought iron	8 Concrete tile	CASING JOINTS: Glued Clamped
1 Steel	3 RMP (SR)	6 Asbestos-Cement	9 Other (specify below)
2 PVC	4 ABS	7 Fiberglass	Welded
Blank casing diameter <u>2</u> in. to ft., Dia. in. to ft., Dia. in. to ft.			Threaded <u>Flush</u>
Casing height above land surface <u>Flush</u> in., weight <u>703</u> lbs./ft. Wall thickness or gauge No. <u>154</u>			
TYPE OF SCREEN OR PERFORATION MATERIAL:	5 Fiberglass	8 RMP (SR)	10 Asbestos-cement
1 Steel	3 Stainless steel	9 ABS	11 Other (specify)
2 Brass	4 Galvanized steel	6 Concrete tile	12 None used (open hole)
SCREEN OR PERFORATION OPENINGS ARE:	5 Gauzed wrapped	8 Saw cut	11 None (open hole)
1 Continuous slot	6 Wire wrapped	9 Drilled holes	
2 Louvered shutter	7 Torch cut	10 Other (specify)	
3 Mill slot			
SCREEN-PERFORATED INTERVALS: From <u>43</u> ft. to <u>33</u> ft., From ft. to ft.			
GRAVEL PACK INTERVALS: From <u>43</u> ft. to <u>32</u> ft., From ft. to ft.			

6 GROUT MATERIAL:	1 Neat cement	2 Cement grout	3 Bentonite	4 Other
Grout Intervals: From <u>32</u> ft. to <u>2</u> ft., From ft. to ft., From ft. to ft.				
What is the nearest source of possible contamination:	1 Septic tank	4 Lateral lines	7 Pit privy	10 Livestock pens
	2 Sewer lines	5 Cess pool	8 Sewage lagoon	11 Fuel storage
	3 Watertight sewer lines	6 Seepage pit	9 Feedyard	12 Fertilizer storage
				13 Insecticide storage
Direction from well? <u>NA</u>				14 Abandoned water well
				15 Oil well/Gas well
				16 Other (specify below)
				How many feet? <u>NA</u>

FROM	TO	LITHOLOGIC LOG	FROM	TO	PLUGGING INTERVALS
0	1.5	Silty Clay Soil			
1.5	23.5	Silty Clay			
23.5	25	Silty Clay w/ Sand			
25	26	Sandy Silt Clay			
26	33.5	Silty Clay			
33.5	42	Sand			
42	44.27	Sand, brown			
44.27	43.2	Shale			
43.2	43.5	Sand			
43.5	44	Shale			
Flush mount waiver granted on 2-4-94 for KDHE # 0607151N, Downs, KS, by Don Taylor					

7 CONTRACTOR'S OR LANDOWNER'S CERTIFICATION: This water well was (1) constructed, (2) reconstructed, or (3) plugged under my jurisdiction and was completed on (mo/day/year) <u>2-15-94</u> and this record is true to the best of my knowledge and belief. Kansas Water Well Contractor's License No. <u>531</u> This Water Well Record was completed on (mo/day/yr) <u>3-24-94</u> under the business name of <u>G.S.I.</u> by (signature) <u>Brenda R. Greenwald</u>
