

County: Osbourne Fraction: SE SE NE SE Sec. 14 T. 6 S R. 15 W

CORRECTION(S) to WATER WELL COMPLETION RECORD Form WWC-5 (to rectify lacking or incorrect information)

Owner: William G Ballard Jr. Domestic (Hand-dug)

If location corrected, was listed as:

Location changed to:

Section-Township-Range: _____

Fraction (1/4 calls): E 1/2 E 1/4

SE SE NE SE

Other changes: Initial statements: Lat./Long coordinates not provided on original form.

Changed to: NAD 83 (39.528011, -98.953255)

Comments: _____

Verification method: Confirmed location with Osbourne Co. Cons. Dist. Manager, Robbin Dibble, and LeoWeb.


Initials: BA Date: 8/7/2024

Submitted by: Kansas Geological Survey, Data Resources Library, 1930 Constant Ave., Lawrence, KS 66047-3724
 Kansas Dept. of Health & Environment, Bureau of Water, 1000 SW Jackson, Suite 420, Topeka, KS 66612-1367

1	LOCATION OF WATER WELL: County: <u>Osborne</u>	Fraction <u>1/4 E 1/4 E 1/4</u>	Section Number <u>14</u>	Township Number <u>T6S</u>	Range Number <u>R15W</u>
---	---	------------------------------------	-----------------------------	-------------------------------	-----------------------------

Distance and direction from nearest town or city street address of well if located within city?
4 miles North of Aiton

2 WATER WELL OWNER: William G Ballard Jr
 RR#, St. Address, Box #: 729 County 657 AVE Board of Agriculture, Division of Water Resources
 City, State, ZIP Code : Aiton KS 67623 Application Number:

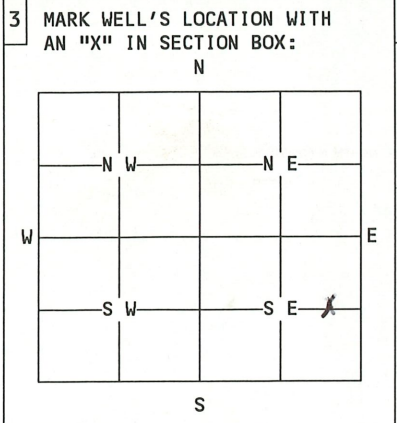

4 DEPTH OF WELL.....ft. 28
 WELL'S STATIC WATER LEVEL.....ft. 18
 WELL WAS USED AS:
 1 Domestic 5 Public Water Supply 9 Dewatering
 2 Irrigation 6 Oil Field Water Supply 10 Monitoring Well
 3 Feedlot 7 Lawn and Garden Only 11 Injection Well
 4 Industrial 8 Air Conditioning 12 Other.....
 Was a chemical/bacteriological sample submitted to Department? Yes....No .
 If yes, mo/day/yr sample was submitted.....
 Water Well Disinfected: Yes No.....

5 TYPE OF BLANK CASING USED:
 1 Steel 3 RMP (SR) 5 Wrought 7 Fiberglass 9 Other (specify below)
 2 PVC 4 ABS 6 Asbestos-Cement 8 Concrete Tile concrete + rock
 Blank casing diameter 72 in. Was casing pulled? Yes..... No . If yes, how much.....
 Casing height above or below land surface 48 in.

6 GROUT PLUG MATERIAL: 1 Neat cement 2 Cement grout 3 Bentonite 4 Other.....
 Grout Plug Intervals: From 4.5 ft. to 5 ft., From.....ft. to.....ft., From..... to.....ft.
 What is the nearest source of possible contamination:
 1 Septic tank 6 Seepage pit 11 Fuel storage 16 Other (specify below)
 2 Sewer lines 7 Pit privy 12 Fertilizer storage rural water
 3 Watertight sewer lines 8 Sewage lagoon 13 Insecticide storage
 4 Lateral lines 9 Feedyard 14 Abandoned water well
 5 Cess Pool 10 Livestock pens 15 Oil well/Gas well
 Direction from well? South How many feet? ... 2000

FROM	TO	PLUGGING MATERIALS
0	4.5	Top soil
4.5	5	Bentonite
5	18	Subsoil
18	28	Sand

RECEIVED
 APR 12 2004
 BUREAU OF WATER

7 CONTRACTOR'S OR LANDOWNER'S CERTIFICATION: This water well was plugged under my jurisdiction and was completed on (mo/day/year) 4-4-24 and this record is true to the best of my knowledge and belief. Kansas Water Well Contractor's License No. This Water Well Record was completed on (mo/day/year) 4-8-24 under the business name of Rex A Johnston LLC by (signature) Rex A Johnston

INSTRUCTIONS: Use typewriter or ball point pen. Please press firmly and print clearly. Please fill in blanks, underline or circle the correct answers. Send top three copies to Kansas Department of Health and Environment, Bureau of Water, Topeka, Kansas 66620-0001. Telephone: 913/296-3565. Send one to Water Well Owner and retain one for your records.