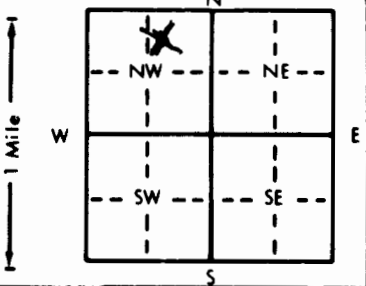


| | | | | |
|---|---|-----------------------------|---------------------------------|--------------------------------------|
| 1 LOCATION OF WATER WELL: County: Cloud | Fraction SW 1/4 NE 1/4 NW 1/4 | Section Number 33 | Township Number T 6 S | Range Number R 2 EW |
|---|---|-----------------------------|---------------------------------|--------------------------------------|

Distance and direction from nearest town or city street address of well if located within city?

3 miles North & 1 mile West of Aurora, KS

| | |
|--|--|
| 2 WATER WELL OWNER: Leonard Reedy RR#, St. Address, Box # : RR 2, Box 122 City, State, ZIP Code : Concordia, KS 66901 | Board of Agriculture, Division of Water Resources Application Number: 49,951 |
|--|--|

| | |
|--|---|
| 3 LOCATE WELL'S LOCATION WITH AN "X" IN SECTION BOX:  | 4 DEPTH OF COMPLETED WELL: 182 ft. ELEVATION: Depth(s) Groundwater Encountered 1. ft. 2. ft. 3. ft. WELL'S STATIC WATER LEVEL: 62 ft. below land surface measured on mo/day/yr 2/10/00 Pump test data: Well water was 156 ft. after 6 hours pumping 280 gpm Est. Yield 300 gpm: Well water was ft. after hours pumping gpm Bore Hole Diameter: 12 in. to 182 ft., and in. to ft. WELL WATER TO BE USED AS: 1 Domestic <input type="checkbox"/> 3 Feedlot <input type="checkbox"/> 5 Public water supply <input type="checkbox"/> 8 Air conditioning <input type="checkbox"/> 11 Injection well <input type="checkbox"/> <input checked="" type="checkbox"/> Irrigation <input type="checkbox"/> 4 Industrial <input type="checkbox"/> 6 Oil field water supply <input type="checkbox"/> 9 Dewatering <input type="checkbox"/> 12 Other (Specify below) <input type="checkbox"/> 7 Lawn and garden only <input type="checkbox"/> 10 Monitoring well <input type="checkbox"/> Was a chemical/bacteriological sample submitted to Department? Yes.....No... <input checked="" type="checkbox"/>; If yes, mo/day/yr sample was submitted Water Well Disinfected? Yes <input checked="" type="checkbox"/> No |
|--|---|

| | |
|---|--|
| 5 TYPE OF BLANK CASING USED: 1 Steel <input type="checkbox"/> 3 RMP (SR) <input type="checkbox"/> 5 Wrought iron <input type="checkbox"/> 8 Concrete tile <input type="checkbox"/> CASING JOINTS: Glued <input checked="" type="checkbox"/> Clamped <input type="checkbox"/> <input checked="" type="checkbox"/> PVC <input type="checkbox"/> 4 ABS <input type="checkbox"/> 6 Asbestos-Cement <input type="checkbox"/> 9 Other (specify below) <input type="checkbox"/> Welded <input type="checkbox"/> 7 Fiberglass <input type="checkbox"/> Threaded <input type="checkbox"/> | Blank casing diameter 8 in. to 122 ft., Dia. in. to ft., Dia. in. to ft. Casing height above land surface 12 in., weight 5.72 lbs./ft. Wall thickness or gauge No. 332 |
| TYPE OF SCREEN OR PERFORATION MATERIAL: 1 Steel <input type="checkbox"/> 3 Stainless steel <input type="checkbox"/> 5 Fiberglass <input type="checkbox"/> 8 RMP (SR) <input type="checkbox"/> 10 Asbestos-cement <input type="checkbox"/> 2 Brass <input type="checkbox"/> 4 Galvanized steel <input type="checkbox"/> 6 Concrete tile <input type="checkbox"/> 9 ABS <input type="checkbox"/> 11 Other (specify) <input type="checkbox"/> 12 None used (open hole) <input type="checkbox"/> | SCREEN OR PERFORATION OPENINGS ARE: 1 Continuous slot <input type="checkbox"/> 3 Mill slot <input checked="" type="checkbox"/> 5 Gauzed wrapped <input type="checkbox"/> 8 Saw cut <input type="checkbox"/> 11 None (open hole) <input type="checkbox"/> 2 Louvered shutter <input type="checkbox"/> 4 Key punched <input type="checkbox"/> 6 Wire wrapped <input type="checkbox"/> 9 Drilled holes <input type="checkbox"/> 7 Torch cut <input type="checkbox"/> 10 Other (specify) <input type="checkbox"/> |
| SCREEN-PERFORATED INTERVALS: From 122 ft. to 182 ft., From ft. to ft. From ft. to ft., From ft. to ft. | GRAVEL PACK INTERVALS: From 20 ft. to 182 ft., From ft. to ft. From ft. to ft., From ft. to ft. |

| | |
|--|---|
| 6 GROUT MATERIAL: 1 Neat cement <input type="checkbox"/> <input checked="" type="checkbox"/> Cement grout 3 Bentonite 4 Other <input type="checkbox"/> | Grout Intervals: From 0 ft. to 20 ft., From ft. to ft., From ft. to ft. |
| What is the nearest source of possible contamination: None within 1/2 mile | 10 Livestock pens 14 Abandoned water well 11 Fuel storage 15 Oil well/Gas well 12 Fertilizer storage 16 Other (specify below) 13 Insecticide storage |
| Direction from well? | How many feet? |

| FROM | TO | LITHOLOGIC LOG | FROM | TO | PLUGGING INTERVALS |
|------|-----|---|------|----|--------------------|
| 0 | 3 | Topsoil | | | |
| 3 | 34 | Tan Clay | | | |
| 34 | 51 | Gray Shale | | | |
| 51 | 130 | Light Gray Shale with Hard Small Sandstone layers | | | |
| 130 | 182 | Sandstone with Hard Layers | | | |
| | | | | | |
| | | | | | |
| | | | | | |
| | | | | | |
| | | | | | |

| |
|--|
| 7 CONTRACTOR'S OR LANDOWNER'S CERTIFICATION: This water well was (1) constructed, (2) reconstructed, or (3) plugged under my jurisdiction and was completed on (mo/day/year) 2/14/00 and this record is true to the best of my knowledge and belief. Kansas Water Well Contractor's License No. 138 This Water Well Record was completed on (mo/day/yr) 2/14/00 under the business name of Peterson Irrigation, Inc. by (signature) <i>Michael Peterson</i> |
|--|

OFFICE USE ONLY
T
R
EW
SEC.
1/4
1/4
1/4