


1 LOCATION OF WATER WELL: Fraction NE 1/4 NE 1/4 NW 1/4 Section Number 8 Township Number T 6 S Range Number R 2 EW

Distance and direction from nearest town or city street address of well if located within city? 1 mi South + 4 mi East of Concordia

2 WATER WELL OWNER: Ed Pick RR#, St. Address, Box #: RR 3, Box 21 City, State, ZIP Code: Concordia, KS 66901 Board of Agriculture, Division of Water Resources Application Number:

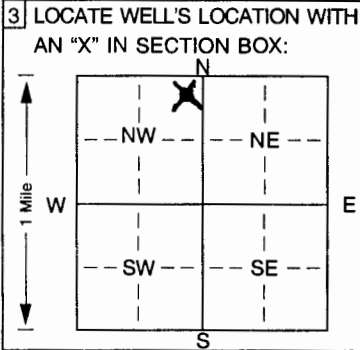

4 DEPTH OF COMPLETED WELL: 83 ft. ELEVATION: WELL'S STATIC WATER LEVEL: 55 ft. below land surface measured on mo/day/yr 8/9/01 Pump test data: Well water was ... ft. after ... hours pumping ... gpm Est. Yield: 20 gpm: Well water was ... ft. after ... hours pumping ... gpm Bore Hole Diameter: 9 in. to 85 in. to ... ft. WELL WATER TO BE USED AS: 5 Public water supply 8 Air conditioning 11 Injection well X Domestic 3 Feedlot 6 Oil field water supply 9 Dewatering 12 Other (Specify below) 2 Irrigation 4 Industrial 7 Domestic (lawn & garden) 10 Monitoring well

5 TYPE OF BLANK CASING USED: 1 Steel 3 RMP (SR) 5 Wrought iron 8 Concrete tile CASING JOINTS: Glued. X Clamped. Welded. Threaded. X PVC 4 ABS 7 Fiberglass 9 Other (specify below)

Blank casing diameter: 5 in. to 73 ft., Dia. Casing height above land surface: 12 in., weight: 2.37 lbs./ft. Wall thickness or gauge No. 214

TYPE OF SCREEN OR PERFORATION MATERIAL: 1 Steel 3 Stainless steel 5 Fiberglass X PVC 10 Asbestos-cement 2 Brass 4 Galvanized steel 6 Concrete tile 8 RMP (SR) 11 Other (specify) 9 ABS 12 None used (open hole)

SCREEN OR PERFORATION OPENINGS ARE: 1 Continuous slot 3 Mill slot 5 Gauzed wrapped 8 Saw cut 11 None (open hole) 2 Louvered shutter 4 Key punched 6 Wire wrapped 9 Drilled holes 7 Torch cut 10 Other (specify) ft.

SCREEN-PERFORATED INTERVALS: From 73 ft. to 83 ft. GRAVEL PACK INTERVALS: From 24 ft. to 83 ft.

6 GROUT MATERIAL: 1 Neat cement 2 Cement grout X Bentonite 4 Other Grout Intervals: From 2 ft. to 24 ft.

What is the nearest source of possible contamination: X Septic tank 4 Lateral lines 7 Pit privy 10 Livestock pens 14 Abandoned water well 2 Sewer lines 5 Cess pool 8 Sewage lagoon 11 Fuel storage 15 Oil well/Gas well 3 Watertight sewer lines 6 Seepage pit 9 Feedyard 12 Fertilizer storage 16 Other (specify below) 13 Insecticide storage

Direction from well? West How many feet? 200

Table with columns: FROM, TO, LITHOLOGIC LOG, FROM, TO, PLUGGING INTERVALS. Rows include Topsoil (0-3), Clay, tan (3-17), Shale, tan (17-62), Sandstone, tan (62-83), Shale, gray (83-85).

7 CONTRACTOR'S OR LANDOWNER'S CERTIFICATION: This water well was X constructed, (2) reconstructed, or (3) plugged under my jurisdiction and was completed on (mo/day/year) 8/10/01 and this record is true to the best of my knowledge and belief. Kansas Water Well Contractor's Licence No. 138 This Water Well Record was completed on (mo/day/yr) 8/13/01 under the business name of Peterson Irrigation, Inc. by (signature) Mike Peterson