


1 LOCATION OF WATER WELL: County: Cloud Fraction SW 1/4 SW 1/4 SW 1/4 Section Number 11 Township Number T 6 S Range Number R 2 E W Distance and direction from nearest town or city street address of well if located within city? Approximately 1 1/4 miles south and 7 1/2 miles east of Concordia Global Positioning Systems (decimal degrees, min. of 4 digits) Latitude: 39.539832 Longitude: -97.51671 Elevation: Unknown Datum: NAD83 Data Collection Method: WAAS GPS Unit

2 WATER WELL OWNER: Everton Energy LLC RR#, St. Address, Box # : 1020 E. 19th Street North City, State, ZIP Code : Wichita, KS 67214

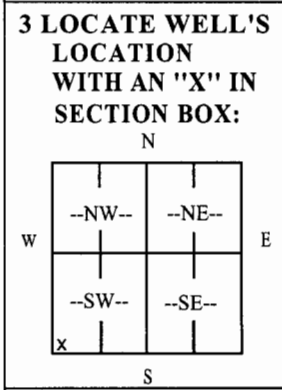

4 DEPTH OF COMPLETED WELL 205 ft. Depth(s) Groundwater Encountered (1) ft. (2) ft. (3) ft. WELL'S STATIC WATER LEVEL 63.72 ft. below land surface measured on mo/day/yr 03-07-07 Pump test data: Well water was Not checked ft. after hours pumping gpm Est. Yield Unknown gpm: Well water was ft. after hours pumping gpm WELL WATER TO BE USED AS: 5 Public water supply 8 Air conditioning 11 Injection well 12 Other (Specify below) Test Well 1 Domestic 3 Feedlot 6 Oil field water supply 9 Dewatering 2 Irrigation 4 Industrial 7 Domestic (lawn & garden) 10 Monitoring well Was a chemical/bacteriological sample submitted to Department? Yes No If yes, mo/day/ys Sample was submitted Water well disinfected? Yes No

5 TYPE OF CASING USED: 5 Wrought Iron 8 Concrete tile CASING JOINTS: Glued Clamped 1 Steel 3 RMP (SR) 6 Asbestos-Cement 9 Other (specify below) Welded 2 PVC 4 ABS 7 Fiberglass Threaded Blank casing diameter 5 in. to 123 ft., Diameter in. to ft., Diameter in. to ft. Casing height above land surface 24 in., weight 2.36 lbs./ft. Wall thickness or gauge No. 214

TYPE OF SCREEN OR PERFORATION MATERIAL: 1 Steel 3 Stainless Steel 5 Fiberglass 7 PVC 9 ABS 11 Other (Specify) 2 Brass 4 Galvanized Steel 6 Concrete tile 8 RM (SR) 10 Asbestos-Cement 12 None used (open hole) SCREEN OR PERFORATION OPENINGS ARE: 1 Continuous slot 3 Mill slot 5 Gauzed wrapped 7 Torch cut 9 Drilled holes 11 None (open hole) 2 Louvered shutter 4 Key punched 6 Wire wrapped 8 Saw Cut 10 Other (Specify) SCREEN-PERFORATED INTERVALS: From 123 ft. to 203 ft., From ft. to ft. GRAVEL PACK INTERVALS: From 30 ft. to 205 ft., From ft. to ft. From ft. to ft. From ft. to ft.

6 GROUT MATERIAL: 1 Neat Cement 2 Cement grout 3 Bentonite 4 Other Bentonite Holeplug Grout Intervals: From ft. to ft., From ft. to ft., From 0 ft. to 30 ft. What is the nearest source of possible contamination: 1 Septic tank 4 Lateral lines 7 Pit privy 10 Livestock pens 13 Insecticide Storage 16 Other (specify below) 2 Sewer lines 5 Cess pool 8 Sewage lagoon 11 Fuel storage 14 Abandoned water well None known 3 Watertight sewer lines 6 Seepage pit 9 Feedyard 12 Fertilizer Storage 15 Oil well/gas well

Direction from well? How many feet? FROM TO LITHOLOGIC LOG FROM TO PLUGGING INTERVALS

0	3	Topsoil	126	129	Clay, gray, hard
3	22	Clay, tan, soft	129	139	Clay, white, hard, with sandstone streaks
22	42	Clay, brown, hard	139	204	Sandstone, soft, tan color, with clay streaks, gray
42	43	Ironstone, hard			
43	47	Clay, tan and white, hard	204	207	Cemented sandstone, hard
47	67	Clay, gray and red, hard	207	211	Clay, dark gray, with shale streaks, hard
67	94	Clay, red and white, hard, with sandstone streaks	211	213	Cemented sandstone, hard
			213	222	Clay, dark gray, hard, with cemented sandstone, hard, and shale streaks
94	111	Clay, gray, hard			
111	126	Sandstone, tan color, soft, with clay streaks, gray	222	227	Sandstone, tan color, with clay streaks, gray
			227	229	Clay, dark gray, hard, with shale streaks

7 CONTRACTOR'S OR LANDOWNER'S CERTIFICATION: This water well was (1) constructed (2) reconstructed (3) plugged under my jurisdiction and was completed on (mo/day/year) 03-07-07 and this record is true to the best of my knowledge and belief. Kansas Water Well Contractor's License No. 185 This Water Well Record was completed on (mo/day/year) 3-14-07 Under the business name of Clarke Well & Equipment, Inc. by (signature)

WATER WELL RECORD

Form WWC-5

Division of Water Resources; App. No.

1 LOCATION OF WATER WELL: County: Cloud Fraction SW 1/4 SW 1/4 SW 1/4 Section Number 11 Township Number T 6 S Range Number R 2 E W
Distance and direction from nearest town or city street address of well if located within city? Approximately 1 1/4 miles south and 7 1/2 miles east of Concordia
Global Positioning Systems (decimal degrees, min. of 4 digits) Latitude: 39.539832 Longitude: -97.51671 Elevation: Unknown Datum: NAD83 Data Collection Method: WAAS GPS Unit

2 WATER WELL OWNER: Everton Energy LLC RR#, St. Address, Box # : 1020 E. 19th Street North City, State, ZIP Code : Wichita, KS 67214
3 LOCATE WELL'S LOCATION WITH AN "X" IN SECTION BOX: [Diagram showing a 3x3 grid with 'X' in the bottom-left corner]
4 DEPTH OF COMPLETED WELL: ft. Depth(s) Groundwater Encountered (1) ft. (2) ft. (3) ft. WELL'S STATIC WATER LEVEL: ft. below land surface measured on mo/day/yr. Pump test data: Well water was ft. after hours pumping gpm Est. Yield gpm: Well water was ft. after hours pumping gpm
WELL WATER TO BE USED AS: 5 Public water supply 8 Air conditioning 11 Injection well 1 Domestic 3 Feedlot 6 Oil field water supply 9 Dewatering 12 Other (Specify below) 2 Irrigation 4 Industrial 7 Domestic (lawn & garden) 10 Monitoring well
Was a chemical/bacteriological sample submitted to Department? Yes No If yes, mo/day/yr
Sample was submitted Water well disinfected? Yes No

5 TYPE OF CASING USED: 5 Wrought Iron 8 Concrete tile CASING JOINTS: Glued Clamped 1 Steel 3 RMP (SR) 6 Asbestos-Cement 9 Other (specify below) Welded 2 PVC 4 ABS 7 Fiberglass Threaded
Blank casing diameter in. to ft., Diameter in. to ft., Diameter in. to ft. Casing height above land surface in., weight lbs./ft. Wall thickness or gauge No.
TYPE OF SCREEN OR PERFORATION MATERIAL: 1 Steel 3 Stainless Steel 5 Fiberglass 7 PVC 9 ABS 11 Other (Specify) 2 Brass 4 Galvanized Steel 6 Concrete tile 8 RM (SR) 10 Asbestos-Cement 12 None used (open hole)
SCREEN OR PERFORATION OPENINGS ARE: 1 Continuous slot 3 Mill slot 5 Gauzed wrapped 7 Torch cut 9 Drilled holes 11 None (open hole) 2 Louvered shutter 4 Key punched 6 Wire wrapped 8 Saw Cut 10 Other (Specify)
SCREEN-PERFORATED INTERVALS: From ft. to ft., From ft. to ft., From ft. to ft. GRAVEL PACK INTERVALS: From ft. to ft., From ft. to ft., From ft. to ft.

6 GROUT MATERIAL: 1 Neat Cement 2 Cement grout 3 Bentonite 4 Other
Grout Intervals: From ft. to ft., From ft. to ft., From ft. to ft.
What is the nearest source of possible contamination: 1 Septic tank 4 Lateral lines 7 Pit privy 10 Livestock pens 13 Insecticide Storage 16 Other (specify below) 2 Sewer lines 5 Cess pool 8 Sewage lagoon 11 Fuel storage 14 Abandoned water well 3 Watertight sewer lines 6 Seepage pit 9 Feedyard 12 Fertilizer Storage 15 Oil well/gas well
Direction from well? How many feet?

Table with columns: FROM, TO, LITHOLOGIC LOG, FROM, TO, PLUGGING INTERVALS. Row 1: 229, 233, Sandstone, soft. Row 2: 233, 240, Clay, dark gray, hard, with shale streaks.

7 CONTRACTOR'S OR LANDOWNER'S CERTIFICATION: This water well was (1) constructed (2) reconstructed (3) plugged under my jurisdiction and was completed on (mo/day/year) 03-07-07 and this record is true to the best of my knowledge and belief. Kansas Water Well Contractor's License No. 185 This Water Well Record was completed on (mo/day/year) 8-14-07 Under the business name of Clarke Well & Equipment, Inc. by (signature)

INSTRUCTIONS: Use typewriter or ball point pen. PLEASE PRESS FIRMLY and PRINT clearly. Please fill in blanks, underline or circle the correct answers. Send top three copies to Kansas Department of Health and Environment, Bureau of Water, Geology Section, 1000 SW Jackson St., Suite 420, Topeka, Kansas 66612-1367. Telephone 785-296-5522. Send one to WATER WELL OWNER and retain one for your records. Fee of \$5.00 for each constructed well.