

WATER WELL RECORD

Form WWC-5


Division of Water Resources App. No.

47,838

1 LOCATION OF WATER WELL: County: Cloud Fraction: 1/4 NE 1/4 NE 1/4 NW 1/4 Section Number: 18 Township No. T 6 S Range Number R 2 E W

Street/Rural Address of Well Location; if unknown, distance & direction from nearest town or intersection: Approximately 2 miles south and 4 miles east of Concordia. Global Positioning System (GPS) information: Latitude: 39.538892 Longitude: -97.583523 Elevation: Unknown

2 WATER WELL OWNER: Bestifor Farms RR#: P.O. Box 220 City, State, ZIP Code: Belleville, KS 66935 Collection Method: GPS unit (Make/Model: WAAS)

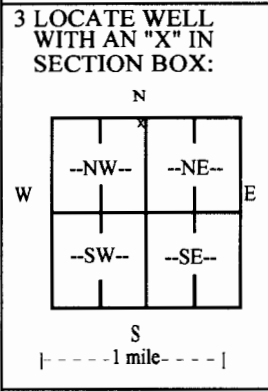

3 LOCATE WELL WITH AN "X" IN SECTION BOX: 4 DEPTH OF COMPLETED WELL: 176 ft. Depth(s) Groundwater Encountered (1) 53 ft. (2) ft. (3) ft. WELL'S STATIC WATER LEVEL 53 ft. below land surface measured on mo/day/yr 08/19/15

5 TYPE OF CASING USED: Steel PVC Other CASING JOINTS: Glued Clamped Welded Threaded Other (Specify) Casing diameter 10 in. to 105 ft., Diameter in. to ft., Diameter in. to ft. Casing height above land surface 12 in., Weight 11.04 lbs./ft., Wall thickness or gauge No. .511

6 GROUT MATERIAL: Neat cement Cement grout Bentonite Other Grout Intervals: From 0 ft. to 20 ft., From ft. to ft., From ft. to ft. What is the nearest source of possible contamination: Septic tank Lateral lines Pit privy Livestock pens Insecticide storage Other (specify below)

Table with columns: FROM, TO, LITHOLOGIC LOG, FROM, TO, LITHO. LOG (cont.) or PLUGGING INTERVALS. Rows include Topsoil, Clay, brown, gray, Clay, gray, yellow, Sandstone, Clay, gray, yellow, Sandstone, Clay, tan, Sandstone, Clay, gray, Sandstone.

7 CONTRACTOR'S OR LANDOWNER'S CERTIFICATION: This water well was constructed, reconstructed, or plugged under my jurisdiction and was completed on (mo/day/year) 08/19/15 and this record is true to the best of my knowledge and belief. Kansas Water Well Contractor's License No. 185 This Water Well Record was completed on (mo/day/year) 08/21/15 under the business name of Clarke Well & Equipment, Inc. by (signature) [Signature]

INSTRUCTIONS: Use typewriter or ball point pen. PLEASE PRESS FIRMLY and PRINT clearly. Please fill in blanks and check the correct answers. Send three copies (white, blue, pink) to Kansas Department of Health and Environment, Bureau of Water, Geology Section, 1000 SW Jackson St., Suite 420, Topeka, Kansas 66612-1367. Telephone 785-296-5522. Send one copy to WATER WELL OWNER and retain one for your records. Include fee of \$5.00 for each constructed well. Visit us at http://www.kdheks.gov/waterwell/index.html.