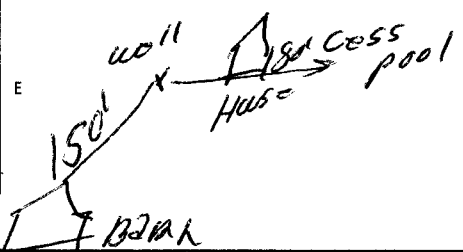


USE TYPEWRITER OR BALL POINT PEN—PRESS FIRMLY, PRINT CLEARLY.

WATER WELL RECORD
KSA 82a-1201-1215

Kansas Department of Health and Environment—Division of Environment (Water well Contractors)
Topeka, Kansas 66620

1. Location of well:	County Graham	Fraction SE 1/4 SE 1/4 SE 1/4	Section number 14	Township number T 6 S	Range number R 23 E/W
2. Distance and direction from nearest town or city: 110 miles North of Hill City Street address of well location if in city:			3. Owner of well: HARDMAN FARMS R.R. or street: RR #1 City, state, zip code: Hill City, Kan. 67642		
4. Locate with "X" in section below: N W E S 1 Mile		Sketch map: 		6. Bore hole dia. 5 in. Completion date 4-14-77 Well depth 158 ft.	
5. Type and color of material		From		To	
		clay		0 25	
		sand & clay		25 40	
		Brown clay		40 56	
		sand & clay STRIPS		56 153	
yellow clay		153 158		7. <input checked="" type="checkbox"/> Cable tool <input checked="" type="checkbox"/> Rotary <input type="checkbox"/> Driven <input type="checkbox"/> Dug <input type="checkbox"/> Hollow rod <input type="checkbox"/> Jetted <input type="checkbox"/> Bored <input type="checkbox"/> Reverse rotary	
153				8. Use: <input checked="" type="checkbox"/> Domestic <input type="checkbox"/> Public supply <input type="checkbox"/> Industry <input type="checkbox"/> Irrigation <input type="checkbox"/> Air conditioning <input type="checkbox"/> Stock <input type="checkbox"/> Lawn <input type="checkbox"/> Oil field water <input type="checkbox"/> Other	
59				9. Casing: Material plastic Height Above or below Threaded <input type="checkbox"/> Welded <input type="checkbox"/> Surface 20 in. RMP <input checked="" type="checkbox"/> PVC <input type="checkbox"/> Weight <input type="checkbox"/> lbs./ft. Dia. 5 in. to 158 ft. depth Wall Thickness: inches or Dia. <input type="checkbox"/> in. to <input type="checkbox"/> ft. depth gage No. 250	
94' set-thick in Og				10. Screen: Manufacturer's name Jess & Lowell Type 6052 92SD Dia. 5" Slot gauze 1/16 Length 10' Set between 4 1/2 ft. and 158 ft. <input type="checkbox"/> ft. and <input type="checkbox"/> ft. Gravel pack? <input checked="" type="checkbox"/> Size range of material 20 to 36	
				11. Static water level: <input type="checkbox"/> mo./day/yr. 59 ft. below land surface Date 11-14-77	
				12. Pumping level below land surfaces: <input type="checkbox"/> ft. after <input type="checkbox"/> hrs. pumping <input type="checkbox"/> g.p.m. <input type="checkbox"/> ft. after <input type="checkbox"/> hrs. pumping <input type="checkbox"/> g.p.m. Estimated maximum yield <input type="checkbox"/> g.p.m.	
				13. Water sample submitted: <input type="checkbox"/> Yes <input checked="" type="checkbox"/> No Date <input type="checkbox"/>	
				14. Well head completion: <input type="checkbox"/> Pitless adapter <input checked="" type="checkbox"/> POH inches above grade	
				15. Well grouted? yes With: <input checked="" type="checkbox"/> Neat cement <input type="checkbox"/> Bentonite <input type="checkbox"/> Concrete Depth: From 5 ft. to 15 ft.	
				16. Nearest source of possible contamination: ft. 80 Direction E Type cass pool Well disinfected upon completion? <input checked="" type="checkbox"/> Yes <input type="checkbox"/> No	
				17. Pump: <input checked="" type="checkbox"/> Not installed Manufacturer's name <input type="checkbox"/> Model number <input type="checkbox"/> HP <input type="checkbox"/> Volts <input type="checkbox"/> Length of drop pipe <input type="checkbox"/> ft. capacity <input type="checkbox"/> g.p.m. Type: <input type="checkbox"/> Submersible <input type="checkbox"/> Turbine <input type="checkbox"/> Jet <input type="checkbox"/> Reciprocating <input type="checkbox"/> Centrifugal <input type="checkbox"/> Other	
18. Elevation:		19. Remarks: client to come: Amendment slab to state Regulations		20. Water well contractor's certification: This well was drilled under my jurisdiction and this report is true to the best of my knowledge and belief. ALL DRILLING CO. 303 Business name License No. Address Hill City, Kan. Signed Allen Spamer Date 4-14-77 Authorized representative	

T 6 S R 23 E W 1/4 1/4 1/4 1/4 1/4