USE TYPEWRITER OR BALL POINT PEN-PRESS FIRMLY, PRINT CLEARLY.

WATER WELL RECORD
KSA 82a-1201-1215

Kansas Department of Health and Environment-Division of Environment
(Water well Contractors)
Topeka, Kansas 66620

ABB DWR# 32824

1. Location of well:	County	Fraction	Section number	Township number	Range number
	Graham	NW 1/4 NW 1/4 NE 1/4	36	T 6 S	R 23 E/W

2. Distance and direction from nearest town or city: 9 N - 1/2 E
Street address of well location if in city: From Hill City

3. Owner of well: Gary Trefler
R.R. or street: 300 S Congress apt 308
City, state, zip code: Austin Texas 78700

4. Locate with "X" in section below:

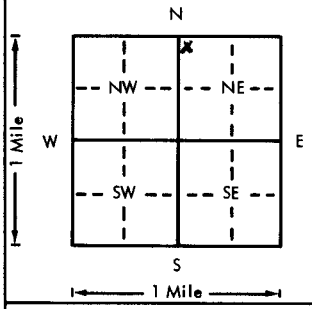

Sketch map:

6. Bore hole dia. 20 in. Completion date 6-2-76
Well depth 152 ft.

7. __ Cable tool __ Rotary __ Driven __ Dug
__ Hollow rod __ Jetted __ Bored ✓ Reverse rotary

8. Use: __ Domestic __ Public supply __ Industry
✓ Irrigation __ Air conditioning __ Stock
__ Lawn __ Oil field water __ Other

9. Casing: Material Steel Height: Above or below
Threaded ___ Welded ✓ Surface 12 in.
RMP ___ PVC ___ Weight ___ lbs./ft.
Dia. 12 3/4 in. to 152 ft. depth Wall Thickness: inches or
Dia. ___ in. to ___ ft. depth gage No. 188

10. Screen: Manufacturer's name W A Brown
Type Louvre Dia. 12 3/4
Slot/gauze 72 Length 40
Set between 112 ft. and 152 ft.
___ ft. and ___ ft.
Gravel pack? ✓ Size range of material 1/4 x 3/8

11. Static water level: mo./day/yr.
40 ft. below land surface Date 5-14-76

12. Pumping level below land surfaces:
___ ft. after ___ hrs. pumping ___ g.p.m.
___ ft. after ___ hrs. pumping ___ g.p.m.
Estimated maximum yield 600 g.p.m.

13. Water sample submitted: mo./day/yr.
__ Yes ✓ No Date ___

14. Well head completion:
__ Pitless adapter 12 Inches above grade

15. Well grouted? ✓
With: ✓ Neat cement ___ Bentonite ___ Concrete
Depth: From 0 ft. to 10 ft.

16. Nearest source of possible contamination:
ft. ___ Direction ___ Type None
Well disinfected upon completion? ___ Yes ___ No

17. Pump: ✓ Not installed
Manufacturer's name ___
Model number ___ HP ___ Volts ___
Length of drop pipe ___ ft. capacity ___ g.p.m.
Type:
__ Submersible __ Turbine
__ Jet __ Reciprocating
__ Centrifugal __ Other

5. Type and color of material	From	To
Top soil	0	55
Fine sand Sandy clay	55	65
Fine Sand M. Gravel	65	75
" " Some Color	75	95
" Sandy Clay	95	105
" M Gravel Some - some Color	105	115
" Sandy Clay	115	125
" "	125	135
" M Gravel Small	135	145
" " "	145	151
Ochre Shale	151	155
DR 151		
(Use a second sheet if needed)		

18. Elevation:

Topography:
__ Hill
__ Slope
✓ Upland
__ Valley

19. Remarks:
Topo 2383
151
2232

20. Water well contractor's certification:
This well was drilled under my jurisdiction and this report is true to the best of my knowledge and belief.
Blue Jay Drilling Inc 214
Business name License No.
Address Box 503 Colby Ks
Signed Merlyn Rall Date 7-2-77
Authorized representative

T 6 R 23 E/W Sec 36 1/4 NW 1/4 NE 1/4

Forward the white, blue and pink copies to the Department of Health and Environment

Form WWC-5