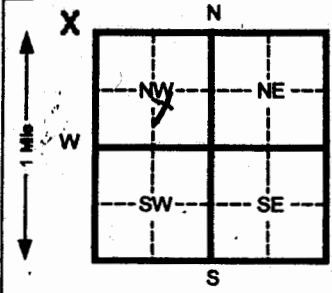


WATER WELL RECORD Form WWC-5 KSA 82a-1212

1 LOCATION OF WATER WELL: County: Graham Fraction: NW 1/4 SE 1/4 NW 1/4 Section Number: 6 Township Number: T 6 S Range Number: R 23 EW

Distance and direction from nearest town or city street address of well if located within city?

2 WATER WELL OWNER: Wyrill Farms Battery 1 of 2
 RR#, St. Address, Box #: P.O. Box 166 Board of Agriculture, Division of Water Resources
 City, State, ZIP Code: Kirwin, Ks 67644 Application Number: 45633

3 LOCATE WELL'S LOCATION WITH AN "X" IN SECTION BOX:


4 DEPTH OF COMPLETED WELL: 127 ft. ELEVATION:
 Depth(s) Groundwater Encountered: 1 ft. 2 ft. 3 ft.
 WELL'S STATIC WATER LEVEL: 30 ft. below land surface measured on mo/day/yr
 Pump test data: Well water was _____ ft. after _____ hours pumping _____ gpm
 Est. Yield: Well water was _____ ft. after _____ hours pumping _____ gpm
 Bore Hole Diameter: 18 in. to 127 ft. and _____ in. to _____ ft.
 WELL WATER TO BE USED AS:
 1 Domestic 3 Feed lot 6 Oil field water supply 8 Air conditioning 11 Injection well
 Irrigation 4 Industrial 7 Lawn and garden (domestic) 9 Dewatering 12 Other (Specify below)
 Was a chemical/bacteriological sample submitted to Department? Yes _____ No X If yes, mo/day/yr sample was submitted
 Water Well Disinfected? Yes X No _____

5 TYPE OF BLANK CASING USED:
 1 Steel 3 RMP (SR) 5 Wrought Iron 8 Concrete tile CASING JOINTS: Glued X Clamped
 2 PVC 4 ABS 6 Asbestos-Cement 9 Other (specify below) Welded _____
 7 Fiberglass Threaded _____
 Blank casing diameter: 10 in. to 67 ft., Dia _____ in. to _____ ft., Dia _____ in. to _____ ft.
 Casing height above land surface: 24 in., weight 7.80 lbs./ft. Wall thickness or gauge No. .365
 TYPE OF SCREEN OR PERFORATION MATERIAL:
 1 Steel 3 Stainless steel 5 Fiberglass 7 PVC 10 Asbestos-cement
 2 Brass 4 Galvanized steel 6 Concrete tile 8 RMP (SR) 11 Other (specify) _____
 9 ABS 12 None used (open hole)
 SCREEN OR PERFORATION OPENINGS ARE:
 1 Continuous slot 3 Mill slot 5 Gauzed wrapped 8 Saw cut 11 None (open hole)
 2 Louvered shutter 4 Key punched 6 Wire wrapped 9 Drilled holes
 7 Torch cut 10 Other (specify) _____
 SCREEN-PERFORATED INTERVALS: From 67 ft. to 127 ft. From _____ ft. to _____ ft.
 GRAVEL PACK INTERVALS: From 20 ft. to 127 ft. From _____ ft. to _____ ft.

6 GROUT MATERIAL: 1 Neat cement 2 Cement grout 3 Bentonite 4 Other
 Grout Intervals From 0 ft. to 20 ft. From _____ ft. to _____ ft. From _____ ft. to _____ ft.
 What is the nearest source of possible contamination:
 1 Septic tank 4 Lateral lines 7 Pit privy 10 Livestock pens 14 Abandoned water well
 2 Sewer lines 5 Cess pool 8 Sewage lagoon 11 Fuel storage 15 Oil well/ Gas well
 3 Watertight sewer lines 6 Seepage pit 9 Feedyard 12 Fertilizer storage 16 Other (specify below)
 13 Insecticide storage none
 Direction from well? _____ How many feet? _____

FROM	TO	CODE	LITHOLOGIC LOG	FROM	TO	PLUGGING INTERVALS
0	2		Surface	122	126	Yellow ochre
2	8		Loess	126	127	Black shale
8	20		Fine to some med sand			
20	30		Clay			
30	42		Fine sand w/sandy clay strks			
42	51		Fine sand w/sandstone strks			
51	54		Sandstone			
54	60		Fine sand w/sandstone strks			
60	69		Sandy clay w/fine sand			
69	75		Clay & caliche			
75	82		Fine sand w/clay strks			
82	92		Fine sand w/clay lens			
92	108		Clay & caliche			
108	122		Fine to med sand w/clay lens			

7 CONTRACTOR'S OR LANDOWNER'S CERTIFICATION: This water well was (1) constructed, (2) reconstructed, or (3) plugged under my jurisdiction and was completed on (mo/day/yr) 4-26-04 and this record is true to the best of my knowledge and belief. Kansas Water Well Contractor's License No. 554 This Water Well Record was completed on (mo/day/yr) 6-18-04 under the business name of Woofter Pump & Well, Inc. by (signature) [Signature]

INSTRUCTIONS: Please fill in blanks and circle the correct answers. Send three copies to Kansas Department of Health and Environment, Bureau of Water, Topeka, Kansas 66620-0001. Telephone: 913-296-5545. Send one to WATER WELL OWNER and retain one for your records.