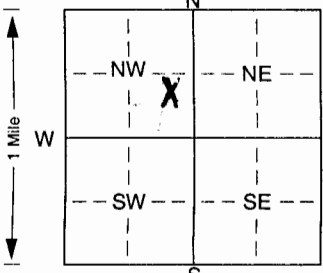


1 LOCATION OF WATER WELL: Fraction NE 1/4 SE 1/4 NW 1/4 Section Number 5 Township Number T 6 S Range Number R 23 WW
 County: Graham

Distance and direction from nearest town or city street address of well if located within city?
From Hill City, KS 13 miles North, 3 miles West

2 WATER WELL OWNER: WYRILL FARMS
 RR#, St. Address, Box #: PO Box 116 Board of Agriculture, Division of Water Resources
 City, State, ZIP Code: KIRWIN, KS 67644 Application Number:

3 LOCATE WELL'S LOCATION WITH AN "X" IN SECTION BOX:

 4 DEPTH OF COMPLETED WELL: 88 ft. ELEVATION: ft.
 Depth(s) Groundwater Encountered 1. ft. 2. ft. 3. ft.
 WELL'S STATIC WATER LEVEL 12 ft. below land surface measured on mo/day/yr 09/21/2006
 Pump test data: Well water was 65 ft. after 2 hours pumping 500 gpm
 Est. Yield 500 gpm; Well water was ft. after hours pumping gpm
 Bore Hole Diameter. 12 1/2 in. to 90 ft., and in. to ft.
 WELL WATER TO BE USED AS: 5 Public water supply 8 Air conditioning 11 Injection well
 1 Domestic 3 Feedlot 6 Oil field water supply 9 Dewatering 12 Other (Specify below)
2 Irrigation 4 Industrial 7 Domestic (lawn & garden) 10 Monitoring well
 Was a chemical/bacteriological sample submitted to Department? Yes. No. X; If yes, mo/day/yr sample was submitted
 Water Well Disinfected? Yes X No

5 TYPE OF BLANK CASING USED:
 1 Steel 3 RMP (SR) 5 Wrought iron 8 Concrete tile CASING JOINTS: Girded X Clamped.
2 PVC 4 ABS 6 Asbestos-Cement 9 Other (specify below) Welded
 Blank casing diameter 8 in. to 88 ft., Dia in. to ft., Dia in. to ft.
 Casing height above land surface 24 in., weight lbs./ft. Wall thickness or gauge No. SA 40
 TYPE OF SCREEN OR PERFORATION MATERIAL:
 1 Steel 3 Stainless steel 5 Fiberglass 7 PVC 10 Asbestos-cement
 2 Brass 4 Galvanized steel 6 Concrete tile 8 RMP (SR) 11 Other (specify)
 9 ABS 12 None used (open hole)
 SCREEN OR PERFORATION OPENINGS ARE:
 1 Continuous slot 3 Mill slot 5 Gauzed wrapped 8 Saw cut 11 None (open hole)
 2 Louvered shutter 4 Key punched 6 Wire wrapped 9 Drilled holes
 7 Torch cut 10 Other (specify) ft.
 SCREEN-PERFORATED INTERVALS: From 48 ft. to 88 ft., From ft. to ft.
 From ft. to ft., From ft. to ft.
 GRAVEL PACK INTERVALS: From 0 ft. to 5 ft., From 26 ft. to 88 ft.
 From ft. to ft., From ft. to ft.

6 GROUT MATERIAL: 1 Neat cement 2 Cement grout 3 Bentonite 4 Other
 Grout Intervals: From 5 ft. to 26 ft., From ft. to ft., From ft. to ft.
 What is the nearest source of possible contamination:
 1 Septic tank 4 Lateral lines 7 Pit privy 10 Livestock pens 14 Abandoned water well
 2 Sewer lines 5 Cess pool 8 Sewage lagoon 11 Fuel storage 15 Oil well/Gas well
 3 Watertight sewer lines 6 Seepage pit 9 Feedyard 12 Fertilizer storage 16 Other (specify below)
NONE
 Direction from well? How many feet?

FROM	TO	LITHOLOGIC LOG	FROM	TO	PLUGGING INTERVALS
0	5	Topsoil + Clay			
5	20	SANDSTONE, w/ Limestone, clay + med sand STRIPS			
20	27	Lime			
27	45	Clay w/ thin med sand STRIPS			
45	65	med. sand w/ thin clay STRIPS			
65	83	COARSE SAND + small GRAVEL			
83	84	FLINT Rock			
84	90	yellow Ocher into SHALE			

7 CONTRACTOR'S OR LANDOWNER'S CERTIFICATION: This water well was (1) constructed, (2) reconstructed, or (3) plugged under my jurisdiction and was completed on (mo/day/year) 09/21/2006 and this record is true to the best of my knowledge and belief. Kansas Water Well Contractor's Licence No. 433 This Water Well Record was completed on (mo/day/yr) 03/24/2006 under the business name of Chris SARGENT Irrigation Co, INC by (signature) Randy Namba