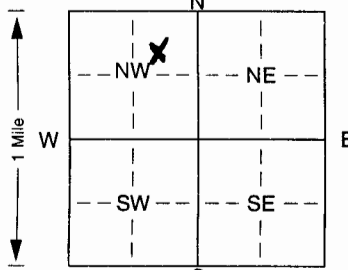


1] LOCATION OF WATER WELL: Fraction SW 1/4 NE 1/4 NW 1/4 Section Number 5 Township Number T 6 S Range Number R 23 SW  
 County: Graham

Distance and direction from nearest town or city street address of well if located within city?  
From Hill City, KS, 13 miles North, 3 miles West

2] WATER WELL OWNER: WYRILL FARMS  
 RR#, St. Address, Box #: P.O. Box 166  
 City, State, ZIP Code: KIRWIN, KS 67644  
 Board of Agriculture, Division of Water Resources  
 Application Number:

3] LOCATE WELL'S LOCATION WITH AN "X" IN SECTION BOX:  
  
 4] DEPTH OF COMPLETED WELL: 84 ft. ELEVATION:  
 Depth(s) Groundwater Encountered 1. 8 ft. 2. 62 ft. 3. 2 ft.  
 WELL'S STATIC WATER LEVEL: 8 ft. below land surface measured on mo/day/yr 09/12/2005  
 Pump test data: Well water was 62 ft. after 2 hours pumping 500 gpm  
 Est. Yield 500 gpm; Well water was 62 ft. after 2 hours pumping 500 gpm  
 Bore Hole Diameter: 12 1/2 in. to 85 ft., and 85 in. to 85 ft.  
 WELL WATER TO BE USED AS:  
 1 Domestic  3 Feedlot  6 Oil field water supply  9 Dewatering  12 Other (Specify below)   
 2 Irrigation  4 Industrial  7 Domestic (lawn & garden)  10 Monitoring well   
 5 Public water supply  8 Air conditioning  11 Injection well   
 Was a chemical/bacteriological sample submitted to Department? Yes.  No. ; If yes, mo/day/yrs sample was submitted  
 Water Well Disinfected? Yes  No

5] TYPE OF BLANK CASING USED:  
 1 Steel  3 RMP (SR)  5 Wrought iron  8 Concrete tile  CASING JOINTS: Glued  Clamped   
 2 PVC  4 ABS  6 Asbestos-Cement  9 Other (specify below)  Welded   
 7 Fiberglass  Threaded   
 Blank casing diameter: 8 in. to 84 ft., Dia. 84 in. to 84 ft., Dia. 84 in. to 84 ft.  
 Casing height above land surface: 24 in., weight 40 lbs./ft. Wall thickness or gauge No. SA 40  
 TYPE OF SCREEN OR PERFORATION MATERIAL:  
 1 Steel  3 Stainless steel  5 Fiberglass  7 PVC  10 Asbestos-cement   
 2 Brass  4 Galvanized steel  6 Concrete tile  8 RMP (SR)  11 Other (specify)   
 9 ABS  12 None used (open hole)   
 SCREEN OR PERFORATION OPENINGS ARE:  
 1 Continuous slot  5 Gauzed wrapped  8 Saw cut  11 None (open hole)   
 2 Louvered shutter  3 Mill slot  6 Wire wrapped  9 Drilled holes   
 4 Key punched  7 Torch cut  10 Other (specify)   
 SCREEN-PERFORATED INTERVALS: From 44 ft. to 84 ft., From 44 ft. to 84 ft., From 44 ft. to 84 ft.  
 GRAVEL PACK INTERVALS: From 0 ft. to 6 ft., From 28 ft. to 84 ft., From 28 ft. to 84 ft.

6] GROUT MATERIAL: 1 Neat cement  2 Cement grout  3 Bentonite  4 Other   
 What is the nearest source of possible contamination:  
 1 Septic tank  4 Lateral lines  7 Pit privy  10 Livestock pens  14 Abandoned water well   
 2 Sewer lines  5 Cess pool  8 Sewage lagoon  11 Fuel storage  15 Oil well/Gas well   
 3 Watertight sewer lines  6 Seepage pit  9 Feedyard  12 Fertilizer storage  16 Other (specify below) NONE  
 13 Insecticide storage   
 Direction from well? \_\_\_\_\_ How many feet? \_\_\_\_\_

FROM	TO	LITHOLOGIC LOG	FROM	TO	PLUGGING INTERVALS
0	10	Topsail into clay			
10	15	Cemented sand w/ med sand strip			
15	22	medium to coarse sand			
22	30	Cemented sand w/ med sand strips			
30	40	med to coarse sand w/ sandstone strips			
40	45	medium to coarse sand			
45	50	med to coarse sand w/ thin clay strips			
50	60	coarse sand			
60	79	coarse sand + small gravel			
79	80	FLINT, Oolite + lime			
80	85	shale + oolite			

7] CONTRACTOR'S OR LANDOWNER'S CERTIFICATION: This water well was (1) constructed (2) reconstructed, or (3) plugged under my jurisdiction and was completed on (mo/day/year) 09/12/2005 and this record is true to the best of my knowledge and belief. Kansas Water Well Contractor's Licence No. 433 This Water Well Record was completed on (mo/day/yr) 03/24/2006 under the business name of Chas Sargent Irrigation Co, Inc by (signature) [Signature]