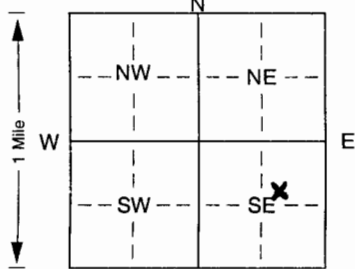


1 LOCATION OF WATER WELL: Fraction SW 1/4 NE 1/4 SE 1/4 Section Number 5 Township Number T 6 S Range Number R 23 W
 County Graham

Distance and direction from nearest town or city street address of well if located within city?
From Hill City, Ks, 13 miles North, 3 miles West

2 WATER WELL OWNER: WYRILL FARMS
 RR#, St. Address, Box # : P.O. Box 166 Board of Agriculture, Division of Water Resources
 City, State, ZIP Code : KIRWIN, KS 67644 Application Number:

3 LOCATE WELL'S LOCATION WITH AN "X" IN SECTION BOX:  DEPTH OF COMPLETED WELL: 204 ft. ELEVATION: _____
 Depth(s) Groundwater Encountered 1. _____ ft. 2. _____ ft. 3. _____ ft.
 WELL'S STATIC WATER LEVEL: 139 ft. below land surface measured on mo/day/yr 09/20/2005
 Pump test data: Well water was 194 ft. after 2 hours pumping 150 gpm
 Est. Yield 150 gpm; Well water was _____ ft. after _____ hours pumping _____ gpm
 Bore Hole Diameter: 12 1/2 in. to 20.6 in. to _____ in. to _____ ft.
 WELL WATER TO BE USED AS: 5 Public water supply 8 Air conditioning 11 Injection well
 1 Domestic 3 Feedlot 6 Oil field water supply 9 Dewatering 12 Other (Specify below)
2 Irrigation 4 Industrial 7 Domestic (lawn & garden) 10 Monitoring well
 Was a chemical/bacteriological sample submitted to Department? Yes. _____ No. X; If yes, mo/day/yr sample was submitted
 Water Well Disinfected? Yes X No _____

5 TYPE OF BLANK CASING USED: 5 Wrought iron 8 Concrete tile CASING JOINTS: Gued. X Clamped. _____
 1 Steel 3 RMP (SR) 6 Asbestos-Cement 9 Other (specify below) Welded _____
2 PVC 4 ABS 7 Fiberglass _____ Threaded _____
 Blank casing diameter 8 in. to 204 ft., Dia _____ in. to _____ ft., Dia _____ in. to _____ ft.
 Casing height above land surface: 24 in., weight _____ lbs./ft. Wall thickness or gauge No. SA 40
 TYPE OF SCREEN OR PERFORATION MATERIAL: 7 PVC 10 Asbestos-cement
 1 Steel 3 Stainless steel 5 Fiberglass 8 RMP (SR) 11 Other (specify) _____
 2 Brass 4 Galvanized steel 6 Concrete tile 9 ABS 12 None used (open hole)
 SCREEN OR PERFORATION OPENINGS ARE: 5 Gauzed wrapped 8 Saw cut 11 None (open hole)
 1 Continuous slot 3 Mill slot 6 Wire wrapped 9 Drilled holes
 2 Louvered shutter 4 Key punched 7 Torch cut 10 Other (specify) _____ ft.
 SCREEN-PERFORATED INTERVALS: From 164 ft. to 204 ft., From _____ ft. to _____ ft.
 From _____ ft. to _____ ft., From _____ ft. to _____ ft.
 GRAVEL PACK INTERVALS: From 0 ft. to 7 ft., From 28 ft. to 204 ft.
 From _____ ft. to _____ ft., From _____ ft. to _____ ft.

6 GROUT MATERIAL: 1 Neat cement 2 Cement grout 3 Bentonite 4 Other _____
 Grout Intervals: From 7 ft. to 28 ft., From _____ ft. to _____ ft., From _____ ft. to _____ ft.
 What is the nearest source of possible contamination:
 1 Septic tank 4 Lateral lines 7 Pit privy 10 Livestock pens 14 Abandoned water well
 2 Sewer lines 5 Cess pool 8 Sewage lagoon 11 Fuel storage 15 Oil well/Gas well
 3 Watertight sewer lines 6 Seepage pit 9 Feedyard 12 Fertilizer storage 16 Other (specify below)
 13 Insecticide storage NONE
 Direction from well? _____ How many feet? _____

FROM	TO	LITHOLOGIC LOG	FROM	TO	PLUGGING INTERVALS
0	20	TOPSOIL & CLAY			
20	80	SANDSTONE, LIMESTONE + MED SAND STRIPS			
80	97	COARSE SAND + SMALL GRAVEL			
97	100	CLAY			
100	108	COARSE SAND + SMALL GRAVEL			
108	136	CLAY w/ SANDSTONE STRIPS			
136	140	MED. + COARSE SAND			
140	145	SANDSTONE			
145	160	MEDIUM TO COARSE SAND			
160	180	MED. SAND w/ SANDSTONE + CLAY STRIPS			
180	204	MED. + COARSE SAND			
204	206	FLINT ROCK INTO YELLOW CLAY			

7 CONTRACTOR'S OR LANDOWNER'S CERTIFICATION: This water well was (1) constructed, (2) reconstructed, or (3) plugged under my jurisdiction and was completed on (mo/day/year) 09/20/2005 and this record is true to the best of my knowledge and belief. Kansas Water Well Contractor's Licence No. 433 This Water Well Record was completed on (mo/day/yr) 03/24/2006 under the business name of Chas SARGENT IRRIGATION Co., INC by (signature) Randy M. M...