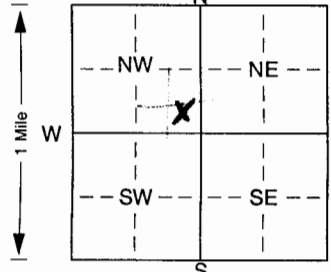


1] LOCATION OF WATER WELL: Fraction SE 1/4 SE 1/4 NW 1/4 Section Number 5 Township Number T 6 S Range Number R 23
 County: GRAHAM

Distance and direction from nearest town or city street address of well if located within city?
From Hill City, Ks. 13 miles North, 3 miles West

2] WATER WELL OWNER: WYRILL FARMS
 RR#, St. Address, Box #: PO Box 146 Board of Agriculture, Division of Water Resources
 City, State, ZIP Code: Kerwin, Ks 67644 Application Number:

3] LOCATE WELL'S LOCATION WITH AN "X" IN SECTION BOX:  4] DEPTH OF COMPLETED WELL: 88 ft. ELEVATION:
 Depth(s) Groundwater Encountered 1. 14 ft. 2. 73 ft. 3. 2 ft.
 WELL'S STATIC WATER LEVEL: 14 ft. below land surface measured on mo/day/yr 09/13/2005
 Pump test data: Well water was 73 ft. after 2 hours pumping 355 gpm
 Est. Yield 400 gpm; Well water was 73 ft. after 2 hours pumping 355 gpm
 Bore Hole Diameter: 12 1/2 in. to 90 ft., and 90 ft. to 90 ft.
 WELL WATER TO BE USED AS: 5 Public water supply 8 Air conditioning 11 Injection well
 1 Domestic 3 Feedlot 6 Oil field water supply 9 Dewatering 12 Other (Specify below)
2 Irrigation 4 Industrial 7 Domestic (lawn & garden) 10 Monitoring well
 Was a chemical/bacteriological sample submitted to Department? Yes. No If yes, mo/day/yr sample was submitted
 Water Well Disinfected? Yes Yes No

5] TYPE OF BLANK CASING USED: 1 Steel 3 RMP (SR) 6 Asbestos-Cement 8 Concrete tile CASING JOINTS: Glued No Clamped
2 PVC 4 ABS 7 Fiberglass 9 Other (specify below) Welded
 Blank casing diameter 8 in. to 88 ft., Dia 88 in. to 88 ft., Dia 88 in. to 88 ft.
 Casing height above land surface 24 in., weight 24 lbs./ft. Wall thickness or gauge No. Sch. 40
 TYPE OF SCREEN OR PERFORATION MATERIAL: 7 PVC 10 Asbestos-cement
 1 Steel 3 Stainless steel 5 Fiberglass 8 RMP (SR) 11 Other (specify)
 2 Brass 4 Galvanized steel 6 Concrete tile 9 ABS 12 None used (open hole)
 SCREEN OR PERFORATION OPENINGS ARE: 3 Mill slot 5 Gauzed wrapped 8 Saw cut 11 None (open hole)
 1 Continuous slot 4 Key punched 6 Wire wrapped 9 Drilled holes
 2 Louvered shutter 7 Torch cut 10 Other (specify) ft.
 SCREEN-PERFORATED INTERVALS: From 48 ft. to 88 ft., From 48 ft. to 88 ft., From 48 ft. to 88 ft.
 GRAVEL PACK INTERVALS: From 0 ft. to 4 ft., From 26 ft. to 88 ft., From 26 ft. to 88 ft.

6] GROUT MATERIAL: 1 Neat cement 2 Cement grout 3 Bentonite 4 Other
 Grout Intervals: From 4 ft. to 26 ft., From 26 ft. to 88 ft., From 26 ft. to 88 ft.
 What is the nearest source of possible contamination:
 1 Septic tank 4 Lateral lines 7 Pit privy 11 Fuel storage 14 Abandoned water well
 2 Sewer lines 5 Cess pool 8 Sewage lagoon 12 Fertilizer storage 15 Oil well/Gas well
 3 Watertight sewer lines 6 Seepage pit 9 Feedyard 13 Insecticide storage NONE 16 Other (specify below)
 Direction from well? How many feet?

FROM	TO	LITHOLOGIC LOG	FROM	TO	PLUGGING INTERVALS
0	13	TOPSOIL + CLAY w/ COBBLSTONE STRIPS			
13	20	MED SAND			
20	40	CLAY w/ MED SAND + SANDSTONE STRIPS			
40	65	SOFT SANDSTONE w/ MED SAND + THIN CLAY STRIPS			
65	80	MED TO COARSE SAND			
80	85	MED. TO COARSE SAND w/ CLAY STRIP			
85	86	FLINT ROCK			
86	90	YELLOW COARSE INTO SHALE			

7] CONTRACTOR'S OR LANDOWNER'S CERTIFICATION: This water well was (1) constructed, (2) reconstructed, or (3) plugged under my jurisdiction and was completed on (mo/day/year) 09/13/2005 and this record is true to the best of my knowledge and belief. Kansas Water Well Contractor's Licence No. 433 This Water Well Record was completed on (mo/day/yr) 03/24/2006 under the business name of CHAS SARGENT IRRIGATION Co., INC by (signature) Randy Mamba