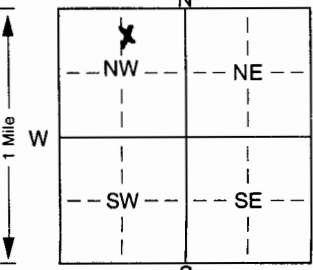


1 LOCATION OF WATER WELL: Fraction NW 1/4 NE 1/4 NW 1/4 Section Number 5 Township Number T 6 S Range Number R 23 NW
 County: Graham

Distance and direction from nearest town or city street address of well if located within city?
From Hill City, Ks. - 13 miles North - 3 miles West

2 WATER WELL OWNER: WYRILL FARMS
 RR#, St. Address, Box #: PO Box 146 Board of Agriculture, Division of Water Resources
 City, State, ZIP Code: KIRWIN, KS 67644 Application Number:

3 LOCATE WELL'S LOCATION WITH AN "X" IN SECTION BOX:

 4 DEPTH OF COMPLETED WELL: 97 ft. ELEVATION:
 Depth(s) Groundwater Encountered: 1. _____ ft. 2. _____ ft. 3. _____ ft.
 WELL'S STATIC WATER LEVEL: 29 ft. below land surface measured on mo/day/yr 9/5/2006
 Pump test data: Well water was 77 ft. after 2 hours pumping 400 gpm
 Est. Yield 400 gpm: Well water was _____ ft. after _____ hours pumping _____ gpm
 Bore Hole Diameter: 12 1/2 in. to 100 ft., and _____ in. to _____ ft.
 WELL WATER TO BE USED AS:
 1 Domestic 3 Feedlot 6 Oil field water supply 8 Air conditioning 11 Injection well
 2 Irrigation 4 Industrial 7 Domestic (lawn & garden) 10 Monitoring well 12 Other (Specify below)
 Was a chemical/bacteriological sample submitted to Department? Yes _____ No _____; If yes, mo/day/yr sample was submitted _____
 Water Well Disinfected? Yes (b) No

5 TYPE OF BLANK CASING USED:
 1 Steel 3 RMP (SR) 5 Wrought iron 8 Concrete tile CASING JOINTS: Glued ✓ Clamped _____
 2 PVC 4 ABS 6 Asbestos-Cement 9 Other (specify below) Welded _____
 7 Fiberglass _____ Threaded _____
 Blank casing diameter 8 in. to 57 ft., Dia _____ in. to _____ ft., Dia _____ in. to _____ ft.
 Casing height above land surface: 29 in., weight _____ lbs./ft. Wall thickness or gauge No. SA 40
 TYPE OF SCREEN OR PERFORATION MATERIAL:
 1 Steel 3 Stainless steel 5 Fiberglass 7 PVC 10 Asbestos-cement
 2 Brass 4 Galvanized steel 6 Concrete tile 8 RMP (SR) 11 Other (specify) _____
 9 ABS 12 None used (open hole)
 SCREEN OR PERFORATION OPENINGS ARE:
 1 Continuous slot 3 Mill slot 5 Gauzed wrapped 8 Saw cut 11 None (open hole)
 2 Louvered shutter 4 Key punched 6 Wire wrapped 9 Drilled holes
 7 Torch cut 10 Other (specify) _____ ft.
 SCREEN-PERFORATED INTERVALS: From 57 ft. to 97 ft., From _____ ft. to _____ ft.
 From _____ ft. to _____ ft., From _____ ft. to _____ ft.
 GRAVEL PACK INTERVALS: From 0 ft. to 5 ft., From 27 ft. to 97 ft.
 From _____ ft. to _____ ft., From _____ ft. to _____ ft.

6 GROUT MATERIAL: 1 Neat cement 2 Cement grout 3 Bentonite 4 Other _____
 Grout Intervals: From 5 ft. to 27 ft., From _____ ft. to _____ ft., From _____ ft. to _____ ft.
 What is the nearest source of possible contamination:
 1 Septic tank 4 Lateral lines 7 Pit privy 10 Livestock pens 14 Abandoned water well
 2 Sewer lines 5 Cess pool 8 Sewage lagoon 11 Fuel storage 15 Oil well/Gas well
 3 Watertight sewer lines 6 Seepage pit 9 Feedyard 12 Fertilizer storage 16 Other (specify below)
 13 Insecticide storage NONE
 Direction from well? _____ How many feet? _____

FROM	TO	LITHOLOGIC LOG	FROM	TO	PLUGGING INTERVALS
0'	10'	Topsoil into Clay			
10'	20'	medium Sand			
20'	40'	Medium Sand w/ Thin Sandstone, Lime & Limestone Strips			
40'	60'	Medium Sand w/ Few Thin Sandy Clay Strips			
60'	97'	Medium Sand + some coarse gravel			
97'	100'	Lime & yellow Ochre			

7 CONTRACTOR'S OR LANDOWNER'S CERTIFICATION: This water well was (1) constructed, (2) reconstructed, or (3) plugged under my jurisdiction and was completed on (mo/day/year) 9/5/2006 and this record is true to the best of my knowledge and belief. Kansas Water Well Contractor's Licence No. 433 This Water Well Record was completed on (mo/day/yr) 9/13/2006 under the business name of Chs. Sargent Irrigation Co., Inc by (signature) Randy M. ...