


1 LOCATION OF WATER WELL:	Fraction	Section Number	Township Number	Range Number
County: Graham	SE 1/4 SE 1/4 SE 1/4	8	T 6 S	R 24 E/W

Distance and direction from nearest town or city street address of well if located within city?  
 Approximately 5 miles south and 2 miles west of Lenora

2 WATER WELL OWNER: City of Lenora  
 RR#, St. Address, Box #: P.O. Box 331  
 City, State, ZIP Code: Lenora, KS 67645  
 Board of Agriculture, Division of Water Resources  
 Application Number: 40,459

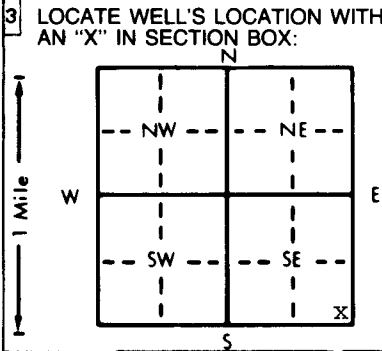

4 DEPTH OF COMPLETED WELL: 215 ft. ELEVATION: unknown  
 Depth(s) Groundwater Encountered 1. ft. 2. ft. 3. ft.  
 WELL'S STATIC WATER LEVEL: 123 ft. below land surface measured on mo/day/yr 10-10-95  
 Pump test data: Well water was not ch'd. ft. after hours pumping gpm  
 Est. Yield unknown gpm: Well water was ft. after hours pumping gpm  
 Bore Hole Diameter: 30 in. to 214 ft., and in. to ft.  
 WELL WATER TO BE USED AS:  
 1 Domestic 3 Feedlot 6 Oil field water supply 9 Dewatering 12 Other (Specify below)  
 2 Irrigation 4 Industrial 7 Lawn and garden only 10 Monitoring well  
 Was a chemical/bacteriological sample submitted to Department? Yes No X; If yes, mo/day/yr sample was submitted  
 Water Well Disinfected? Yes X No

5 TYPE OF BLANK CASING USED:  
 1 Steel 3 RMP (SR) 5 Wrought iron 8 Concrete tile CASING JOINTS: Glued Clamped  
 2 PVC 4 ABS 6 Asbestos-Cement 9 Other (specify below) Welded X  
 7 Fiberglass Threaded  
 Blank casing diameter: 12 3/4 in. to 170 ft., Dia 12 3/4 in. to 185 ft., Dia in. to ft.  
 Casing height above land surface: 18 in., weight 49.56 lbs./ft. Wall thickness or gauge No. 375  
 TYPE OF SCREEN OR PERFORATION MATERIAL:  
 1 Steel 3 Stainless steel 5 Fiberglass 8 RMP (SR) 10 Asbestos-cement 11 Other (specify)  
 2 Brass 4 Galvanized steel 6 Concrete tile 9 ABS 12 None used (open hole)  
 SCREEN OR PERFORATION OPENINGS ARE:  
 1 Continuous slot 3 Mill slot 5 Gauzed wrapped 8 Saw cut 11 None (open hole)  
 2 Louvered shutter 4 Key punched 7 Torch cut 9 Drilled holes  
 10 Other (specify)  
 SCREEN-PERFORATED INTERVALS: From 170 ft. to 180 ft., From ft. to ft.  
 From 185 ft. to 213.5 ft., From ft. to ft.  
 GRAVEL PACK INTERVALS: From 150 ft. to 214 ft., From ft. to ft.  
 From ft. to ft., From ft. to ft.

6 GROUT MATERIAL: 1 Neat cement 2 Cement grout Clean sand 3 Bentonite 4 Other Bentonite Holeplug  
 Grout intervals: From 0-5 ft. to 5-48ft., From 48-100 ft. to 100-145 ft., From 145 ft. to 150 ft.  
 What is the nearest source of possible contamination:  
 1 Septic tank 4 Lateral lines 7 Pit privy 10 Livestock pens 14 Abandoned water well  
 2 Sewer lines 5 Cess pool 8 Sewage lagoon 11 Fuel storage 15 Oil well/Gas well  
 3 Watertight sewer lines 6 Seepage pit 9 Feedyard 12 Fertilizer storage 16 Other (specify below)  
 13 Insecticide storage None known  
 Direction from well? How many feet?

FROM	TO	LITHOLOGIC LOG	FROM	TO	PLUGGING INTERVALS
0	2	Topsoil	107	115	Clay, brown
2	17	Clay	115	128	Clay, tan
17	20	Clay, sandy with sand streaks	128	145	Cemented sand and clay, brown, hard
20	30	Cemented sand, hard	145	165	Clay, sandy with sand streaks
30	38	Sand and gravel, medium	165	170	Sand, fine
38	40	Clay, brown	170	175	Sand and gravel, fine, medium
40	50	Sand and gravel, medium	175	180	Sand and gravel, fine
50	60	Clay, brown with cemented sand streaks	180	185	Cemented sand, hard
60	80	Clay, white with cemented sand streaks	185	190	Sand, very fine
80	91	Clay, green and white	190	194	Sand and gravel, fine, medium
91	100	Sand and gravel, medium	194	195	Clay streak
100	102	Sand, very fine	195	214	Sand and gravel, fine, medium
102	107	Clay, brown and green			

7 CONTRACTOR'S OR LANDOWNER'S CERTIFICATION: This water well was (1) constructed, (2) reconstructed, or (3) plugged under my jurisdiction and was completed on (mo/day/year) 10-10-95 and this record is true to the best of my knowledge and belief. Kansas Water Well Contractor's License No. 185 This Water Well Record was completed on (mo/day/yr) 10-20-95 under the business name of Clarke Well & Equipment, Inc. by (signature) *Clarke W. Clarke*