


1 LOCATION OF WATER WELL: Fraction SW 1/4 SE 1/4 SW 1/4 Section Number 4 Township Number T 6 S Range Number R 27 E (W)  
 County: Graves

Distance and direction from nearest town or city street address of well if located within city?  
14 miles North Omaha, Kansas and 1/2 mile West

2 WATER WELL OWNER: Hallett Jamison  
 RR#, St. Address, Box #: Box 49 Lenora Kansas 67645 Board of Agriculture, Division of Water Resources  
 City, State, ZIP Code: Lenora Kansas 67645 Application Number:

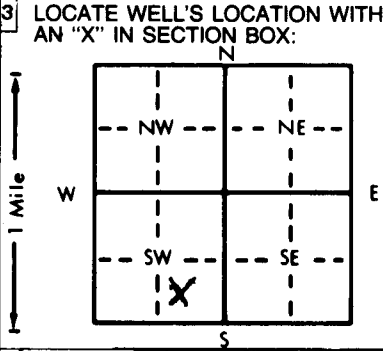

4 DEPTH OF COMPLETED WELL: 66 ft. ELEVATION:  
 Depth(s) Groundwater Encountered 1. 40 feet ft. 2. ft. 3. ft.  
 WELL'S STATIC WATER LEVEL ft. below land surface measured on mo/day/yr  
 Pump test data: Well water was ft. after hours pumping gpm  
 Est. Yield gpm: Well water was ft. after hours pumping gpm  
 Bore Hole Diameter: 10 in. to ft., and in. to ft.  
 WELL WATER TO BE USED AS:  
 1 Domestic  3 Feedlot  6 Oil field water supply  9 Dewatering  12 Other (Specify below)  
 2 Irrigation  4 Industrial  7 Lawn and garden only  10 Observation well  
 Was a chemical/bacteriological sample submitted to Department? Yes No ; If yes, mo/day/yr sample was submitted  
 Water Well Disinfected? Yes No

5 TYPE OF BLANK CASING USED:  
 1 Steel  3 RMP (SR)  6 Asbestos-Cement  9 Other (specify below)  Welded   
 2 PVC  4 ABS  7 Fiberglass  Threaded   
 Blank casing diameter 5" in. to 46 ft., Dia. in. to ft., Dia. in. to ft.  
 Casing height above land surface 20" in., weight 160 lb. lbs./ft. Wall thickness or gauge No.  
 TYPE OF SCREEN OR PERFORATION MATERIAL:  
 1 Steel  3 Stainless steel  5 Fiberglass  8 RMP (SR)  11 Other (specify)   
 2 Brass  4 Galvanized steel  6 Concrete tile  9 ABS  12 None used (open hole)   
 SCREEN OR PERFORATION OPENINGS ARE:  
 1 Continuous slot  3 Mill slot  6 Wire wrapped  9 Drilled holes   
 2 Louvered shutter  4 Key punched  7 Torch cut  10 Other (specify)   
 SCREEN-PERFORATED INTERVALS: From 46 ft. to 66 ft., From ft. to ft.  
 From ft. to ft., From ft. to ft.  
 GRAVEL PACK INTERVALS: From 20 ft. to 66 ft., From ft. to ft.  
 From ft. to ft., From ft. to ft.

6 GROUT MATERIAL: 1 Neat cement  2 Cement grout  3 Bentonite  4 Other   
 Grout intervals: From ft. to ft., From ft. to ft., From ft. to ft.  
 What is the nearest source of possible contamination:  
 1 Septic tank  4 Lateral lines  7 Pit privy  10 Livestock pens  14 Abandoned water well   
 2 Sewer lines  5 Cess pool  8 Sewage lagoon  11 Fuel storage  15 Oil well/Gas well   
 3 Watertight sewer lines  6 Seepage pit  9 Feedyard  12 Fertilizer storage  16 Other (specify below)   
 13 Insecticide storage  Dam   
 Direction from well? How many feet? 600 feet

FROM	TO	LITHOLOGIC LOG	FROM	TO	LITHOLOGIC LOG
0	15	Levy Clay			
15	25	Hard yellow clay			
25	36	Fine sand & clay			
36	66	Large sand & fine gravel			
66	80	Hard clay + no sand			

7 CONTRACTOR'S OR LANDOWNER'S CERTIFICATION: This water well was (1) constructed, (2) reconstructed, or (3) plugged under my jurisdiction and was completed on (mo/day/year) June 15th, 1989 and this record is true to the best of my knowledge and belief. Kansas Water Well Contractor's License No. 444 This Water Well Record was completed on (mo/day/yr) June 15, 1989 under the business name of Jamison Drilling by (signature) Hallett Jamison