


USE TYPEWRITER OR BALL POINT PEN-PRESS FIRMLY, PRINT CLEARLY.

WATER WELL RECORD
KSA 82a-1201-1215

Kansas Department of Health and Environment-Division of Environment (Water well Contractors) Topeka, Kansas 66620

1. Location of well: County Madison Fraction SE 1/4 NE 1/4 NE 1/4 Section number 19 Township number T 6 S Range number R 24 E 01

2. Distance and direction from nearest town or city: 6 1/2 S Lanona 3. Owner of well: Belle Olson
Street address of well location if in city: 35 1/2 N Main R.R. or street:
City, state, zip code: Lanona Kansas

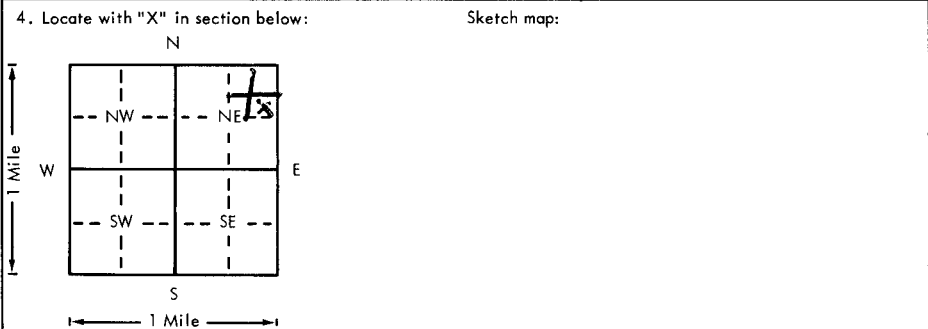

6. Bore hole dia. 9 in. Completion date 9-30-99
Well depth 235 ft.
7. Cable tool Rotary Driven Dug
 Hollow rod Jetted Bored Reverse rotary
8. Use: Domestic Public supply Industry
 Irrigation Air conditioning Stock
 Lawn Oil field water Other
9. Casing: Material _____ Height: Above or below
Threaded _____ Welded _____ Surface 12 in.
RMP _____ PVC Weight 2000 lbs./ft.
Dia. 2 in. to 235 ft. depth Wall Thickness: inches or
Dia. _____ in. to _____ ft. depth gage No. 318

5. Type and color of material	From	To
Top soil	0	27
Sandy clay, sandstone	27	108
Sandy clay	108	124
Sandstone	124	140
M, gravel, gravel	140	200
Sandy Clay	200	210
Fine Sand	210	224
M, gravel	224	233
Ochre	233	235
233		
145'		
88' set thick		

10. Screen: Manufacturer's name Jim Lowell
Type PVC Dia. 5"
Slot/gauze 1/4" Length 8'
Set between 228 ft. and 235 ft.
ft. and _____ ft.
Gravel pack? Size range of material 1/4 1/2
11. Static water level: _____ mo./day/yr.
145 ft. below land surface Date 9-30-99
12. Pumping level below land surfaces:
_____ ft. after _____ hrs. pumping _____ g.p.m.
_____ ft. after _____ hrs. pumping _____ g.p.m.
Estimated maximum yield 30 g.p.m.
13. Water sample submitted: _____ mo./day/yr.
 Yes No Date _____
14. Well head completion:
 Pitless adapter 12 Inches above grade
15. Well grouted?
With: Neat cement Bentonite Concrete
Depth: From 4 ft. to 14 ft.
16. Nearest source of possible contamination:
ft. 150' Direction C Type Septic
Well disinfected upon completion? Yes No
17. Pump: _____ Not installed
Manufacturer's name Stouffer
Model number 1021 HP 1 Volts _____
Length of drop pipe 181 ft. capacity 10 g.p.m.
Type:
 Submersible Turbine
 Jet Reciprocating
 Centrifugal Other

18. Elevation: _____
19. Remarks: ADA
2225
233
2273

20. Water well contractor's certification:
This well was drilled under my jurisdiction and this report is true to the best of my knowledge and belief.
B+B Drilling 396
Business name License No.
Address Murrell, KS
Signed Joseph Beckman Date 11-5-99
Authorized representative

T 6 S R 24 E 01
24 E 01
19
SE 1/4 NE 1/4