USE TYPEWRITER OR BALL POINT PEN-PRESS FIRMLY, PRINT CLEARLY.

Unwell

T R EW sec 1/4 1/4 1/4 No.

WATER WELL RECORD
KSA 82a-1201-1215

~~4CA~~ ADB (KGS B.D.#7)

Kansas State Dept. Of Health
(Water Well Contractors)
Forbes-Bldg. 740
Topeka, Kansas 66620

1 Location of well:	County	Township name	Fraction	Section number	Town number	Range number
	Graham	Indiana N	NE¼SW¼NE¼	23	6	24W

Distance and direction from nearest town or city: From Penokee, Ks. 10½ miles North; ½mile East

Street address of well location if in city:

3 Owner of well: Carl Striggow

Address: Studley, Kansas

Locate with "X" in section below:

N
W X E
S
1 Mile

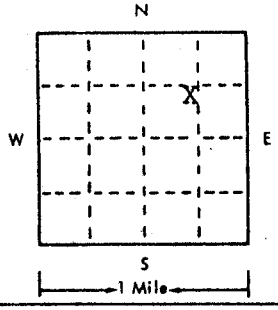

Sketch map:

4 Well depth: 142 ft. Date of completion 1/16/76
Well diameter 30 in.

5 ☐ Cable tool ☐ Rotary ☐ Driven ☐ Dug ☐ Hollow rod ☐ Jetted ☐ Bored ☒ Reverse rotary

6 Use: ☐ Domestic ☐ Public supply ☐ Industry ☒ Irrigation ☐ Air conditioning ☐ Commercial ☐ Test well ☐

7 Casing: Material Steel Height: above ~~below~~
Threaded ☐ Welded ☒ Surface 12 in.
Diam. Weight ___ lbs./ft.
16 in. to 32 ft. depth Drive shoe? ☐ Yes ☒ No
___ in. to ___ ft. depth

2 Type and color of material	From	To
Soil & clay	0	15
Medium sand	15	50
Clay & rock	50	60
Clay	60	88
Fine to medium sand	88	137
Clay	137	140
Rock	140	144
Yellow clay & shale	144	150
BROCK 144'		
(use a second sheet if needed)		

8 Screen:
Manufacturer Brown: 10' Cook
Type Regular Dia. 16"
Slot/gauze 10% Length 100'
Set between 32 ft. and 132 ft. 142
Fittings: ¼X5/8:50% #1
Gravel pack ☒ Yes ☐ No Size range of material ___

9 Static water level:
52 ft. below land surface Date 1/17/76

10 Pumping level below land surfaces:
130 ft. after 2 hrs. pumping 1084 g.p.m.
___ ft. after ___ hrs. pumping ___ g.p.m.
Estimated maximum yield 1084 g.p.m.

11 Water sample submitted:
☐ Yes ☒ No Date ___

12 Well head completion:
☐ Pitless adapter ☒ 12 Inches above grade

13 Well grouted? ☒ Yes ☐ No
☐ Neat cement ☒ Bentonite ☒ Clay
Depth: From 0 ft. to 10 ft.

14 Nearest source of possible contamination:
ft. 2600 Direction South Type Farm
Well disinfected upon completion? ☐ Yes ☒ No

15 Pump: ☐ Not installed
Manufacturer's name Floway 2/10/76
Model number 7623 HP 125 Volts ___
Length of drop pipe 130 ft. capacity ___ g.m.p.
Type: 8 stage 12" DOL bowl
☐ Submersible ☒ Turbine
☐ Jet ☐ Reciprocating
☐ Centrifugal ☐ Other

16 Remarks: elevation

Topography:
☐ Hill
☐ Slope
☒ Upland
☐ Valley

2400 Tpm (KGS BD#7)
144
2256

17 Water well contractor's certification:
This well was drilled under my jurisdiction and this report is true to the best of my knowledge and belief.
Western Well and Pump 245
Business name License No.
Address PO Box 852 Colby, Ks.
Signed Sally Berry Date 3/22/76
Authorized representative

6 24W 23 NE SW NE

Forward the white, blue and pink copies to the Kansas State Dept. Of Health.

Form WWC-5