USE TYPEWRITER OR BALL POINT PEN-PRESS FIRMLY, PRINT CLEARLY.

LEN WIDST

AWR# 27078

WATER WELL RECORD
KSA 82a-1201-1215

should be DCD (AGS BD #7)

Kansas Department of Health and Environment-Division of Environment
(Water well Contractors)
Topeka, Kansas 66620

1. Location of well:	County	Fraction	Section number	Township number	Range number
	GRAHAM	~~SW 1/4~~ ~~NW 1/4~~ ~~SW 1/4~~	22	T 6 S	R 25 E/W

2. Distance and direction from nearest town or city: 11 N.
Street address of well location if in city: MORLAND

3. Owner of well: Gary D. & Patricia Bangle
R.R. or street: R.R. 1
City, state, zip code: Morland Ko.

4. Locate with "X" in section below: Sketch map:

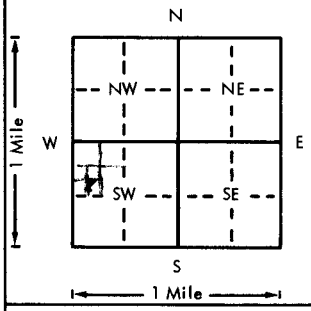

6. Bore hole dia. 16 in. Completion date 6-7-76
Well depth 291 ft.

7. __ Cable tool __ Rotary __ Driven __ Dug
__ Hollow rod __ Jetted __ Bored X Reverse rotary

8. Use: __ Domestic __ Public supply __ Industry
X Irrigation __ Air conditioning __ Stock
__ Lawn __ Oil field water __ Other

9. Casing: Material Steel Height: Above or below
Threaded ___ Welded ✓ Surface 12 in.
RMP ___ PVC ___ Weight ___ lbs./ft.
Dia. 10 in. to 291 ft. depth Wall Thickness: inches or
Dia. ___ in. to ___ ft. depth gage No. 188

5. Type and color of material	From	To
Top soil		
Fine sand Sandy Clay	0	155
✓ ✓	155	175
✓ ✓	175	195
Fine sand M. Gravel Streak Sandy clay Streak Sand stone	195	215
✓ ✓ ✓ ✓	215	235
✓ ✓ ✓ ✓	235	245
✓ Streak M. Gravel Sandy clay	245	255
✓ Med Gravel fine Colored	255	265
✓ ✓ ✓	265	290
290 Shale	290	291
141		
149' soil thick BROCK 290		
in Og		
(Use a second sheet if needed)		

10. Screen: Manufacturer's name W.A. Brown
Type Power Dia. 16
Slot/gauze ___ Length ___
Set between 211 ft. and 291 ft.
___ ft. and ___ ft.
Gravel pack? yes Size range of material 1/4 x 3/8

11. Static water level: mo./day/yr.
141 ft. below land surface Date 6-14-76

12. Pumping level below land surfaces:
136 ft. after 3 hrs. pumping 1000 g.p.m.
___ ft. after ___ hrs. pumping ___ g.p.m.
Estimated maximum yield 1100 g.p.m.

13. Water sample submitted: mo./day/yr.
__ Yes ✓ No Date ___

14. Well head completion:
__ Pitless adapter 12 Inches above grade

15. Well grouted? ✓
With: ✓ Neat cement __ Bentonite __ Concrete
Depth: From 0 ft. to 10 ft.

16. Nearest source of possible contamination:
ft. ___ Direction ___ Type None
Well disinfected upon completion? ___ Yes ✓ No

17. Pump: ✓ Not installed
Manufacturer's name ___
Model number ___ HP ___ Volts ___
Length of drop pipe ___ ft. capacity ___ g.p.m.
Type:
__ Submersible __ Turbine
__ Jet __ Reciprocating
__ Centrifugal __ Other

T 6 S R 25 E/W Sec 22 1/4 1/4 1/4 1/4 SWNWSW

18. Elevation:
Topography:
__ Hill
__ Slope
X Upland
__ Valley

19. Remarks:
TOPO
2563 ft
290
2273

20. Water well contractor's certification:
This well was drilled under my jurisdiction and this report is true to the best of my knowledge and belief.
Bangle Drilling Co. 214
Business name License No.
Address Box 503 Colby Ko
Signed Marilyn Bell Date 4-7-77
Authorized representative

Forward the white, blue and pink copies to the Department of Health and Environment

Form WWC-5