


1 LOCATION OF WATER WELL: County: GRAHAM Fraction SW 1/4 SW 1/4 NW 1/4 Section Number 27 Township Number T 6 S Range Number R 25 EW

Distance and direction from nearest town or city street address of well if located within city? 1 1/2 W + 10 N of MORLAND, KS

2 WATER WELL OWNER: STEPHEN J. HICKERT RR#, St. Address, Box #: HCR 1 BOX 14 City, State, ZIP Code: MORLAND, KS 67650-9755 Board of Agriculture, Division of Water Resources Application Number:

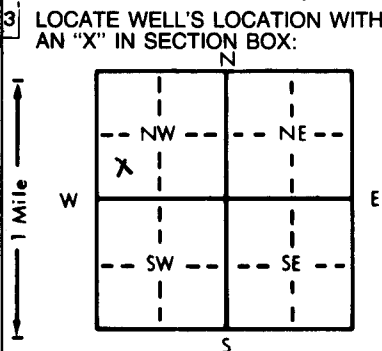

3 LOCATE WELL'S LOCATION WITH AN 'X' IN SECTION BOX: 4 DEPTH OF COMPLETED WELL: 130? ft. ELEVATION: Depth(s) Groundwater Encountered 1? ft. 2? ft. 3? ft. WELL'S STATIC WATER LEVEL: 125? ft. below land surface measured on mo/day/yr Pump test data: Well water was ? ft. after ? hours pumping ? gpm Est. Yield ? gpm: Well water was ? ft. after ? hours pumping ? gpm Bore Hole Diameter: ? in. to ? ft., and ? in. to ? ft. WELL WATER TO BE USED AS: 5 Public water supply 8 Air conditioning 11 Injection well 6 Domestic 3 Feedlot 6 Oil field water supply 9 Dewatering 12 Other (Specify below) 2 Irrigation 4 Industrial 7 Lawn and garden only 10 Monitoring well Was a chemical/bacteriological sample submitted to Department? Yes.....No.....; If yes, mo/day/yr sample was submitted Water Well Disinfected? Yes No

5 TYPE OF BLANK CASING USED: 1 Steel 3 RMP (SR) 5 Wrought iron 8 Concrete tile CASING JOINTS: Glued.....Clamped..... 2 PVC 4 ABS 6 Asbestos-Cement 9 Other (specify below) Welded..... Threaded..... Blank casing diameter: 5 in. to ? ft., Dia. ? in. to ? ft., Dia. ? in. to ? ft. Casing height above land surface: ? in., weight ? lbs./ft. Wall thickness or gauge No. TYPE OF SCREEN OR PERFORATION MATERIAL: 1 Steel 3 Stainless steel 5 Fiberglass 8 RMP (SR) 11 Other (specify) 2 Brass 4 Galvanized steel 6 Concrete tile 9 ABS 12 None used (open hole) SCREEN OR PERFORATION OPENINGS ARE: 1 Continuous slot 3 Mill slot 5 Gauzed wrapped 8 Saw cut 11 None (open hole) 2 Louvered shutter 4 Key punched 6 Wire wrapped 9 Drilled holes 10 Other (specify) SCREEN-PERFORATED INTERVALS: From ? ft. to ? ft., From ? ft. to ? ft. GRAVEL PACK INTERVALS: From ? ft. to ? ft., From ? ft. to ? ft.

6 GROUT MATERIAL: 1 Neat cement 2 Cement grout 3 Bentonite 4 Other Grout Intervals: From ? ft. to ? ft., From ? ft. to ? ft. What is the nearest source of possible contamination: 1 Septic tank 4 Lateral lines 7 Pit privy 11 Fuel storage 15 Oil well/Gas well 2 Sewer lines 5 Cess pool 8 Sewage lagoon 12 Fertilizer storage 16 Other (specify below) 3 Watertight sewer lines 6 Seepage pit 9 Feedyard 13 Insecticide storage

Direction from well? How many feet? FROM TO LITHOLOGIC LOG FROM TO PLUGGING INTERVALS

FROM	TO	LITHOLOGIC LOG	FROM	TO	PLUGGING INTERVALS
			130	10	WASHED SAND
			10	5	BENTONITE
			5	0	SAND (WILL REPLACE WITH TOPSOIL WHEN I DIG OUT THE CEMENT PAD).

7 CONTRACTOR'S OR LANDOWNER'S CERTIFICATION: This water well was (1) constructed, (2) reconstructed, or (3) plugged under my jurisdiction and was completed on (mo/day/year) 3-12-89 and this record is true to the best of my knowledge and belief. Kansas Water Well Contractor's License No. This Water Well Record was completed on (mo/day/yr) 3-20-89 under the business name of by (signature) Stephen J. Hickert