

USE TYPEWRITER OR BALL POINT PEN-PRESS FIRMLY, PRINT CLEARLY.

WATER WELL RECORD  
KSA 82a-1201-1215


Kansas Department of Health and Environment-Division of Environment (Water well Contractors) Topeka, Kansas 66620

LUCERNE

DIA

1. Location of well: County GRAHAM Fraction NE 1/4 SE 1/4 SE 1/4 Section number 29 Township number T 6 S R 25 E Range number 25

2. Distance and direction from nearest town or city: 9 1/2 N - 2 E - 1/4 N 3. Owner of well: Ivan Best  
Street address of well location if in city: Studley, Kansas. R.R. or street: Rural Route  
City, state, zip code: Morland, Kansas

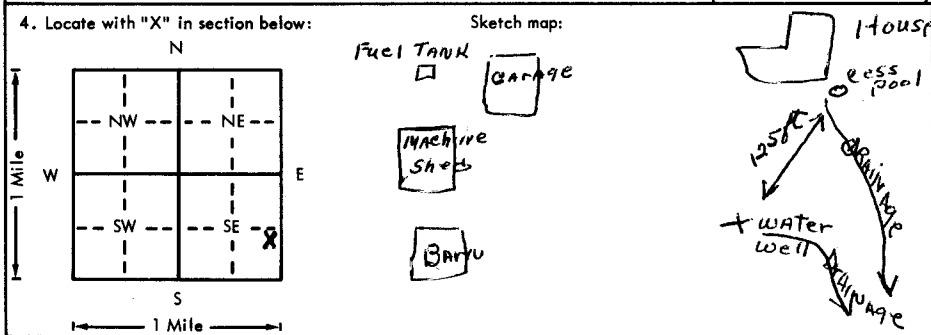

6. Bore hole dia. 8 1/2 in. Completion date 2-21-76  
Well depth \_\_\_\_\_ ft.

7. Cable tool  Rotary \_\_\_\_\_ Driven \_\_\_\_\_ Dug \_\_\_\_\_  
Hollow rod \_\_\_\_\_ Jetted \_\_\_\_\_ Bored \_\_\_\_\_ Reverse rotary \_\_\_\_\_

8. Use:  Domestic \_\_\_\_\_ Public supply \_\_\_\_\_ Industry \_\_\_\_\_  
Irrigation \_\_\_\_\_ Air conditioning \_\_\_\_\_ Stock \_\_\_\_\_  
Lawn \_\_\_\_\_ Oil field water \_\_\_\_\_ Other \_\_\_\_\_

9. Casing: Material PVC Height: Above or below \_\_\_\_\_  
Threaded \_\_\_\_\_ Welded St Surface 16 in. \_\_\_\_\_  
RMP 4 PVC \_\_\_\_\_ Weight 1.8 lbs./ft. \_\_\_\_\_  
Dia. 5 in. to 270 ft. depth, Wall Thickness: inches or \_\_\_\_\_  
Dia. \_\_\_\_\_ in. to \_\_\_\_\_ ft. depth, gage No. 250

5. Type and color of material	From	To
Top soil BIK	0	3'
Clay Greyish yellow	3'	16'
SAND BROWN	16	22
Clay - Grey	22	140
Limestone clay + Fine SAND, Grey	140	150
Rock whitish Grey	150	171.8
Rock Grey	171.8	180'
Water Gravel BROWN	180'	257
Clay + sand Mixed Grey Brown Fairly <sup>CON</sup> part	257	270
SHALE Grey BIK		270
BROCK 270		
135		
135' sat that in Og		
276.3 Topo Top		
270		
2293		

10. Screen: Manufacturer's name Jess + Lowell  
Type \_\_\_\_\_ Dia. 5"  
Cloth gauze 3/32 Length 100  
Set between 160 ft. and 260 ft. \_\_\_\_\_  
ft. and \_\_\_\_\_ ft. \_\_\_\_\_  
Gravel pack?  Size range of material 1/8-1/4

11. Static water level: \_\_\_\_\_ mo./day/yr.  
135 ft. below land surface Date \_\_\_\_\_

12. Pumping level below land surfaces:  
140 ft. after 1/2 hrs. pumping 12 g.p.m.  
\_\_\_\_\_ ft. after \_\_\_\_\_ hrs. pumping \_\_\_\_\_ g.p.m.  
Estimated maximum yield 100 g.p.m.

13. Water sample submitted: \_\_\_\_\_ mo./day/yr.  
Yes  No \_\_\_\_\_ Date \_\_\_\_\_

14. Well head completion:  
Pitless adapter 16 inches above grade

15. Well grouted?   
With: \_\_\_\_\_ Neat cement \_\_\_\_\_ Bentonite  Concrete \_\_\_\_\_  
Depth: From 0 ft. to 10 ft.

16. Nearest source of possible contamination:  
ft. 135 Direction NE Type Cesspool  
Well disinfected upon completion?  Yes \_\_\_\_\_ No \_\_\_\_\_

17. Pump:  Not installed  
Manufacturer's name \_\_\_\_\_  
Model number \_\_\_\_\_ HP \_\_\_\_\_ Volts \_\_\_\_\_  
Length of drop pipe \_\_\_\_\_ ft. capacity \_\_\_\_\_ g.p.m.  
Type:  
\_\_\_\_\_ Submersible \_\_\_\_\_ Turbine  
\_\_\_\_\_ Jet \_\_\_\_\_ Reciprocating  
\_\_\_\_\_ Centrifugal \_\_\_\_\_ Other \_\_\_\_\_

18. Elevation:  
Topography:  
\_\_\_\_\_ Hill  
\_\_\_\_\_ Slope  
 Upland  
\_\_\_\_\_ Valley

19. Remarks: He knows about the Concrete Platform or slab regulation.

20. Water well contractor's certification:  
This well was drilled under my jurisdiction and this report is true to the best of my knowledge and belief.  
P. Bradford Water Well Drilling & Supply  
Business name \_\_\_\_\_ License No. 294  
Address Mill City, Kansas  
Signed Paul E. Bradford Date 2-17-76  
Authorized representative \_\_\_\_\_

T-16 250 E 29 NE SE SE 1/4 1/4 1/4 1/4