


WATER WELL RECORD Form WWC-5 KSA 82a-1212

1] LOCATION OF WATER WELL: County: **GRAHAM** Fraction: **SE 1/4 SE 1/4 NE 1/4** Section Number: **30** Township Number: **T 6 S** Range Number: **R 25 EW**

Distance and direction from nearest town or city street address of well if located within city?

2] WATER WELL OWNED BY: **EDWIN JEFFERY**
 RR#, St. Address, Box # **RR 1 Box 26**
 City, State, ZIP Code **MORLAND KS, 67650**
 Board of Agriculture, Division of Water Resources
 Application Number:

3] LOCATE WELL'S LOCATION WITH AN "X" IN SECTION BOX: 4] DEPTH OF COMPLETED WELL: **100** ft. ELEVATION:

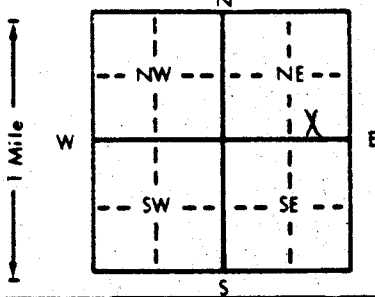

Depth(s) Groundwater Encountered **NONE** ft. 2. ft. 3. ft.
 WELL'S STATIC WATER LEVEL ft. below land surface measured on mo/day/yr
 Pump test data: Well water was ft. after hours pumping gpm
 Est. Yield gpm: Well water was ft. after hours pumping gpm
 Bore Hole Diameter in. to ft., and in. to ft.
 WELL WATER TO BE USED AS: 5 Public water supply 8 Air conditioning 11 Injection well
 Domestic 3 Feedlot 6 Oil field water supply 9 Dewatering 12 Other (Specify below)
 2 Irrigation 4 Industrial 7 Lawn and garden only 10 Monitoring well
 Was a chemical/bacteriological sample submitted to Department? Yes No; If yes, mo/day/yr sample was submitted
 Water Well Disinfected? Yes No

5] TYPE OF BLANK CASING USED:
 Steel 3 RMP (SR)
 2 PVC 4 ABS
 5 Wrought iron 8 Concrete tile CASING JOINTS: Glued Clamped
 6 Asbestos-Cement 9 Other (specify below) Welded
 7 Fiberglass Threaded

Blank casing diameter 5 in. to ft., Dia in. to ft., Dia in. to ft.
 Casing height above land surface 2.4 in., weight lbs./ft. Wall thickness or gauge No.

TYPE OF SCREEN OR PERFORATION MATERIAL:
 1 Steel 3 Stainless steel 5 Fiberglass 7 PVC 10 Asbestos-cement
 2 Brass 4 Galvanized steel 6 Concrete tile 8 RMP (SR) 11 Other (specify)
 9 ABS 12 None used (open hole)

SCREEN OR PERFORATION OPENINGS ARE:
 1 Continuous slot 3 Mill slot 5 Gauzed wrapped 8 Saw cut 11 None (open hole)
 2 Louvered shutter 4 Key punched 6 Wire wrapped 9 Drilled holes
 7 Torch cut 10 Other (specify)

SCREEN-PERFORATED INTERVALS: From ft. to ft., From ft. to ft.
 From ft. to ft., From ft. to ft.
 GRAVEL PACK INTERVALS: From ft. to ft., From ft. to ft.
 From ft. to ft., From ft. to ft.

6] GROUT MATERIAL: Neat cement 2 Cement grout 3 Bentonite 4 Other
 Grout intervals: From 7 ft. to **Top of Pump** From ft. to ft., From ft. to ft.
 What is the nearest source of possible contamination: **Basel**
 1 Septic tank 4 Lateral lines 7 Pit privy 10 Livestock pens 14 Abandoned water well
 2 Sewer lines 5 Cess pool 8 Sewage lagoon 11 Fuel storage 15 Oil well/Gas well
 3 Watertight sewer lines 6 Seepage pit 9 Feedyard 12 Fertilizer storage 16 Other (specify below)
 13 Insecticide storage
 Direction from well? **North** How many feet?

FROM	TO	LITHOLOGIC LOG	FROM	TO	PLUGGING INTERVALS
			100	80	Sand
			80	13	Clay
			7		to pump Basel Cement

7] CONTRACTOR'S OR LANDOWNER'S CERTIFICATION: This water well was (1) constructed, (2) reconstructed, or (3) plugged under my jurisdiction and was completed on (mo/day/year) **April 3, 89** and this record is true to the best of my knowledge and belief. Kansas Water Well Contractor's License No. This Water Well Record was completed on (mo/day/yr) by (signature) **Edwin Jeffery**
 under the business name of