

708' E of 116'S NW CRNR 31-6-25

USE TYPEWRITER OR BALL POINT PEN-PRESS FIRMLY, PRINT CLEARLY.

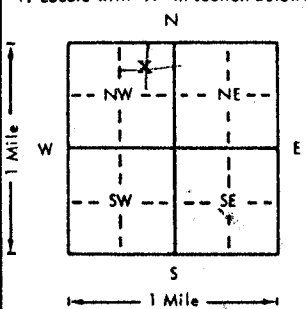
BAR

WATER WELL RECORD  
KSA 82a-1201-1215

luuuuu

Kansas Department of Health and Environment-Division of Environment (Water well Contractors) Topeka, Kansas 66620

66A (DWR Records)

1. Location of well: County: <b>Graham</b>		Fraction: <b>NW</b> <del>NE</del> 1/4 <b>NW</b> 1/4 <del>NE</del> 1/4 <b>NW</b> 1/4		Section number: <b>31</b>		Township number: <b>T 6 S R 25</b>		Range number: <b>XW</b>	
2. Distance and direction from nearest town or city: <b>From county line at Studley; 10 M N; 1/2 M E, S into field</b> Street address of well location if in city:				3. Owner of well: <b>Gerald Brewster</b> R.R. or street: <b>Studley, Kansas</b> City, state, zip code:					
4. Locate with "X" in section below: 				Sketch map:		6. Bore hole dia. <u>30</u> in. Completion date <u>7-21-76</u> Well depth <u>330</u> ft.			
5. Type and color of material				From		To		7. <u>  </u> Cable tool <u>  </u> Rotary <u>  </u> Driven <u>  </u> Dug <u>  </u> Hollow rod <u>  </u> Jetted <u>  </u> Bored <input checked="" type="checkbox"/> Reverse rotary	
Clay				0		73		8. Use: <u>  </u> Domestic <u>  </u> Public supply <u>  </u> Industry <input checked="" type="checkbox"/> Irrigation <u>  </u> Air conditioning <u>  </u> Stock <u>  </u> Lawn <u>  </u> Oil field water <u>  </u> Other	
Sand and Gravel and Clay Streaks				73		102		9. Casing: Material <u>Steel</u> Height: Above or <del>Below</del> Threaded <u>  </u> Welded <u>  </u> Surface <u>12</u> in. RMP <u>  </u> PVC <u>  </u> Weight <u>188</u> lbs./ft. Dia. <u>16</u> in. to <u>200</u> ft. depth Wall Thickness: inches or Dia. <u>  </u> in. to <u>  </u> ft. depth gage No. <u>#7</u>	
Clay				102		130		10. Screen: Manufacturer's name <u>  </u> <u>Brown</u> Type <u>Regular</u> Dia. <u>16"</u> Slot/gauze <u>10%</u> Length <u>120"</u> Set between <u>200-220'</u> ft. and <u>230-330'</u> ft. <u>10'</u> <u>220'</u> ft. and <u>230'</u> ft. Screen <u>  </u> Gravel pack? <input checked="" type="checkbox"/> Size range of material <u>1/2 x 5/8</u>	
Sand and Gravel				130		141		11. Static water level: <u>  </u> mo./day/yr. <u>173</u> ft. below land surface Date <u>7-23-76</u>	
Sandy Clay				141		150		12. Pumping level below land surfaces: <u>296</u> ft. after <u>2</u> hrs. pumping <u>495</u> g.p.m. <u>  </u> ft. after <u>  </u> hrs. pumping <u>  </u> g.p.m. Estimated maximum yield <u>495</u> g.p.m.	
Cemented Sand and Gravel and Clay Streak				150		158		13. Water sample submitted: <u>  </u> mo./day/yr. <u>  </u> Yes <input checked="" type="checkbox"/> No Date <u>  </u>	
Medium Coarse Sand				158		180		14. Well head completion: <u>  </u> Pitless adapter <u>12</u> Inches above grade	
Clay				180		194		15. Well grouted? <input checked="" type="checkbox"/> With: <u>  </u> Neat cement <input checked="" type="checkbox"/> Bentonite <input checked="" type="checkbox"/> <u>Clay</u> Depth: From <u>0</u> ft. to <u>10</u> ft.	
Coarse Sand and Gravel				194		205		16. Nearest source of possible contamination: ft. <u>2600'</u> Direction <u>S</u> Type <u>Farm</u> Well disinfected upon completion? <u>  </u> Yes <input checked="" type="checkbox"/> No	
Clay				205		207		17. Pump: <u>  </u> Not installed Manufacturer's name <u>Floway</u> Model number <u>056101</u> HP <u>80</u> Volts <u>  </u> Length of drop pipe <u>320</u> ft. capacity <u>  </u> g.p.m. Type: <u>9</u> stage <u>10"</u> DKM Bowl <u>  </u> Submersible <input checked="" type="checkbox"/> Turbine <u>  </u> Jet <u>  </u> Reciprocating <u>  </u> Centrifugal <u>  </u> Other	
Coarse Sand and Gravel				207		219		18. Elevation:	
Clay				219		221		19. Remarks: <b>2632</b> <sup>fm-top</sup> <b>328</b> <b>2304</b>	
Coarse Sand and Gravel				221		233		20. Water well contractor's certification: This well was drilled under my jurisdiction and this report is true to the best of my knowledge and belief. <b>Western Well &amp; Pump</b> 245 Business name License No. Address <b>Box 852, Colby, KS 67701</b> Signed <b>Shelly Barry</b> Date <b>9-15-76</b> Authorized representative	
Fine Coarse Sand and Clay Mix				233		261		IN APP # 27,476	
Clay				261		285		(Use a second sheet if needed)	
Coarse Sand and Gravel				285		291		Sec 1-16 25' 31' NE 1/4 NW 1/4	
Clay				291		306			
Sandy Clay				306		313			
Clay and Ochre				313		324			
Sand and Gravel				324		328			
Ochre and Shale				328		340			