


1 LOCATION OF WATER WELL: County: SHERIDAN Fraction: 1/4 SE 1/4 SE 1/4 SE 1/4 Section Number: 12 Township Number: T 6 S Range Number: R 26 E/NT

Distance and direction from nearest town or city street address of well if located within city? 13N 1E of Study

2 WATER WELL OWNER: FRED TEEJ
 RR#, St. Address, Box # :
 City, State, ZIP Code : HAYS KS.
 Board of Agriculture, Division of Water Resources
 Application Number:

3 LOCATE WELL'S LOCATION WITH AN "X" IN SECTION BOX:

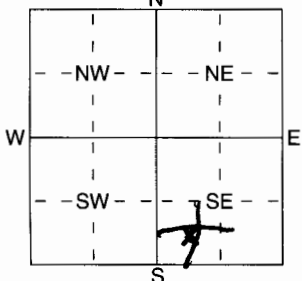

DEPTH OF COMPLETED WELL: 175 ft. ELEVATION:
 Depth(s) Groundwater Encountered 1 85 ft. 2 ft. 3 ft.
 WELL'S STATIC WATER LEVEL 75 ft. below land surface measured on mo/day/yr
 Pump test data: Well water was ft. after hours pumping gpm
 Est. Yield 20 gpm: Well water was ft. after hours pumping gpm
 WELL WATER TO BE USED AS:
 1 Domestic 3 Feedlot 5 Public water supply 8 Air conditioning 11 Injection well
 2 Irrigation 4 Industrial 6 Oil field water supply 9 Dewatering 12 Other (Specify below)
 7 Domestic (lawn & garden) 10 Monitoring well STOCK
 Was a chemical/bacteriological sample submitted to Department? Yes No X; If yes, mo/day/yrs sample was submitted
 Water Well Disinfected? Yes No

5 TYPE OF BLANK CASING USED:
 1 Steel 3 RMP (SR) 5 Wrought iron 8 Concrete tile CASING JOINTS: Glued X Clamped
 2 PVC 4 ABS 7 Fiberglass 9 Other (specify below) Welded
 Blank casing diameter 5 in. to 155 ft., Dia in. to ft., Dia in. to ft.
 Casing height above land surface 12 in., weight 250 lbs./ft. Wall thickness or guage No. 250
 TYPE OF SCREEN OR PERFORATION MATERIAL:
 1 Steel 3 Stainless Steel 5 Fiberglass 8 RMP (SR) 10 Asbestos-Cement
 2 Brass 4 Galvanized Steel 6 Concrete tile 9 ABS 11 Other (Specify)
 12 None used (open hole)
 SCREEN OR PERFORATION OPENINGS ARE:
 1 Continuous slot 3 Mill slot 5 Guazed wrapped 8 Saw cut 11 None (open hole)
 2 Louvered shutter 4 Key punched 6 Wire wrapped 9 Drilled holes
 7 Torch cut 10 Other (specify) ft.
 SCREEN-PERFORATED INTERVALS: From 155 ft. to 175 ft., From ft. to ft.
 GRAVEL PACK INTERVALS: From 85 ft. to 175 ft., From ft. to ft.

6 GROUT MATERIAL: 1 Neat cement 2 Cement grout 3 Bentonite 4 Other
 Grout Intervals: From 0 ft. to 90 ft., From ft. to ft., From ft. to ft.
 What is the nearest source of possible contamination:
 1 Septic tank 4 Lateral lines 7 Pit privy 10 Livestock pens 14 Abandoned water well
 2 Sewer lines 5 Cess pool 8 Sewage lagoon 11 Fuel storage 15 Oil well/Gas well
 3 Watertight sewer lines 6 Seepage pit 9 Feedyard 12 Fertilizer storage 16 Other (specify below)
 13 Insecticide storage
 Direction from well? EAST How many feet? 150

FROM	TO	LITHOLOGIC LOG	FROM	TO	PLUGGING INTERVALS
0	14	Top soil			
14	72	Sandy Clay			
72	78	GRAVEL			
78	148	SANDY CLAY			
148	164	FINE SAND			
164	174	SANDSTONE			
174	175	SHALE			

7 CONTRACTOR'S OR LANDOWNER'S CERTIFICATION: This water well was (1) constructed, (2) reconstructed, or (3) plugged under my jurisdiction and was completed on (mo/day/year) 6-28-05 and this record is true to the best of my knowledge and belief. Kansas Water Well Contractor's Licence No. 376 This Water Well Record was completed on (mo/day/year) 6-28-05 under the business name of B+B Drilling by (signature) Joseph Bedner