


1 LOCATION OF WATER WELL: Fraction **SW ¼ SW ¼ NW ¼** Section Number **28** Township Number **T 6 S** Range Number **R 26W EW**
 County: **Sheridan**

Distance and direction from nearest town or city street address of well if located within city?

2 WATER WELL OWNER: **Doris Stowell**
 RR#, St. Address, Box #: **162 2nd St** Board of Agriculture, Division of Water Resources
 City, State, ZIP Code: **Phillipsburg, KS 67661** Application Number: **20060456**

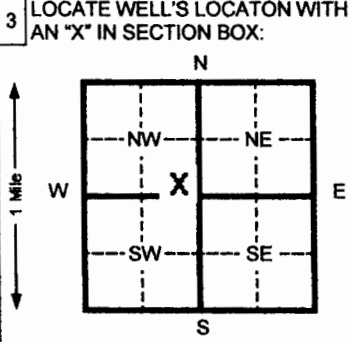

4 DEPTH OF COMPLETED WELL **265** ft. ELEVATION: _____
 Depth(s) Groundwater Encountered 1 _____ ft. 2 _____ ft. 3 _____ ft.
 WELL'S STATIC WATER LEVEL **NA** ft. below land surface measured on mo/day/yr
 Pump test data: Well water was _____ ft. after _____ hours pumping _____ gpm
 Est. Yield _____ gpm: Well water was _____ ft. after _____ hours pumping _____ gpm
 Bore Hole Diameter **8** in. to **265** ft. and _____ in. to _____ ft.
 WELL WATER TO BE USED AS: Public water supply Air conditioning Injection well
 Domestic Feed lot Oil field water supply Dewatering Other (Specify below)
 Irrigation Industrial Lawn and garden (domestic) Monitoring well
 Was a chemical/bacteriological sample submitted to Department? Yes _____ No If yes, mo/day/yr sample was submitted _____
 Water Well Disinfected? Yes _____ No

5 TYPE OF BLANK CASING USED:
 Steel RMP (SR) Wrought Iron Concrete tile CASING JOINTS: Glued Clamped
 PVC ABS Fiberglass Other (specify below) Welded _____
 Fiberglass _____ Threaded _____
 Blank casing diameter **4.5** in. to **225** ft. Dia _____ in. to _____ ft. Dia _____ in. to _____ ft.
 Casing height above land surface **18** in., weight **2.38** lbs./ft. Wall thickness or gauge No. **248**
 TYPE OF SCREEN OR PERFORATION MATERIAL:
 Steel Stainless steel Fiberglass PVC Asbestos-cement
 Brass Galvanized steel Concrete tile RMP (SR) Other (specify)
 None used (open hole)
 SCREEN OR PERFORATION OPENINGS ARE:
 Continuous slot Mill slot Gauzed wrapped Saw cut None (open hole)
 Louvered shutter Key punched Wire wrapped Drilled holes
 Torch cut Other (specify)
 SCREEN-PERFORATED INTERVALS: From **225** ft. to **265** ft. From _____ ft. to _____ ft.
 From _____ ft. to _____ ft. From _____ ft. to _____ ft.
 GRAVEL PACK INTERVALS: From **20** ft. to **265** ft. From _____ ft. to _____ ft.
 From _____ ft. to _____ ft. From _____ ft. to _____ ft.

6 GROUT MATERIAL: Neat cement Cement grout Bentonite Other _____
 Grout Intervals From **0** ft. to **20** ft. From _____ ft. to _____ ft. From _____ ft. to _____ ft.
 What is the nearest source of possible contamination:
 Septic tank Lateral lines Pit privy Livestock pens Abandoned water well
 Sewer lines Cess pool Sewage lagoon Fuel storage Oil well/ Gas well
 Watertight sewer lines Seepage pit Feedyard Fertilizer storage Other (specify below)
 Insecticide storage None

Direction from well? _____ How many feet? _____

FROM	TO	CODE	LITHOLOGIC LOG	FROM	TO	PLUGGING INTERVALS
0	2		Surface	157	180	Clay w/ Caliche
2	13		Loess	180	202	Clay w/ Caliche Strks
13	33		Clay	202	220	Fine to Some Med Sand w/ Clay & Caliche
33	36		Clay w/ Gravel Strks			Caliche
36	53		Fine to Med Sand	220	231	Fine to Med Sand w/ Clay & Caliche
53	65		Clay w/ Caliche Strks	231	248	Clay & Caliche
65	76		Fine - Med Snd w/ Clay & calche	248	258	Fine to Med Sand
76	100		Clay & Caliche w/ Sand Strks	258	270	Yellow Ochre/ Shale
100	115		Clay & Caliche w/ Sand Strks			
115	123		Fine to Med Sand w/ Sandstone			
123	134		Clay w/ Caliche			
134	140		Caliche			
140	152		Clay w/ Caliche			
152	157		Fine to Med Sand			

7 CONTRACTOR'S OR LANDOWNER'S CERTIFICATION: This water well was (1) constructed, (2) reconstructed, or (3) plugged under my jurisdiction and was completed on (mo/day/yr) **12-01-06** and this record is true to the best of my knowledge and belief. Kansas Water Well Contractor's License No. **554** This Water Well Record was completed on (mo/day/yr) **12-12-06** under the business name of **Woofter Pump & Well Inc.** by (signature) *Jan C. Woofter*