


1 LOCATION OF WATER WELL: Fraction **SE 1/4 NE 1/4 NW 1/4** Section Number **33** Township Number **T 6 S** Range Number **R 28 E**
 County: **Sheridan**
 Distance and direction from nearest town or city street address of well if located within city?

2 WATER WELL OWNER: **Frank Sulzman**
 RR#, St. Address, Box # : **R R 2, Box 110** Board of Agriculture, Division of Water Resources
 City, State, ZIP Code : **Selden, Ks 67757** Application Number:

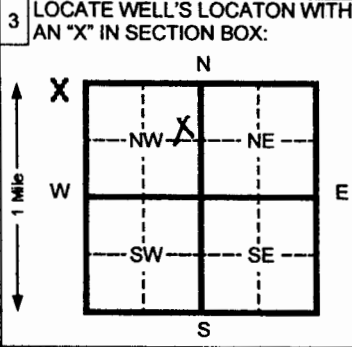

4 DEPTH OF COMPLETED WELL **158** ft. ELEVATION:
 Depth(s) Groundwater Encountered 1 _____ ft. 2 _____ ft. 3 _____ ft.
 WELL'S STATIC WATER LEVEL _____ ft. below land surface measured on mo/day/yr
 Pump test data: Well water was _____ ft. after _____ hours pumping _____ gpm
 Est. Yield _____ gpm: Well water was _____ ft. after _____ hours pumping _____ gpm
 Bore Hole Diameter **8** in. to **156** ft. and _____ in. to _____ ft.
 WELL WATER TO BE USED AS: 5 Public water supply 8 Air conditioning 11 Injection well
 1 Domestic 3 Feed lot 6 Oil field water supply 9 Dewatering 12 Other (Specify below)
 2 Irrigation 4 Industrial 7 Lawn and garden (domestic) 10 Monitoring well
 Was a chemical/bacteriological sample submitted to Department? Yes _____ No **X** If yes, mo/day/yr sample was submitted
 Water Well Disinfected? Yes **X** No

5 TYPE OF BLANK CASING USED:
 1 Steel 3 RMP (SR) 5 Wrought Iron 8 Concrete tile CASING JOINTS: Glued **X** Clamped
 2 PVC 4 ABS 6 Asbestos-Cement 9 Other (specify below) Welded
 7 Fiberglass Threaded
 Blank casing diameter **4.5** in. to **118** ft., Dia _____ in. to _____ ft., Dia _____ in. to _____ ft.
 Casing height above land surface **4.5** in., weight **2.38** lbs./ft. Wall thickness or gauge No. **.248**
 TYPE OF SCREEN OR PERFORATION MATERIAL:
 1 Steel 3 Stainless steel 5 Fiberglass 8 RMP (SR) 10 Asbestos-cement
 2 Brass 4 Galvanized steel 6 Concrete tile 9 ABS 11 Other (specify)
 SCREEN OR PERFORATION OPENINGS ARE:
 1 Continuous slot 3 Mill slot 5 Gauzed wrapped 8 Saw cut 11 None (open hole)
 2 Louvered shutter 4 Key punched 6 Wire wrapped 9 Drilled holes
 7 Torch cut 10 Other (specify)
 SCREEN-PERFORATED INTERVALS: From **118** ft. to **158** ft. From _____ ft. to _____ ft.
 GRAVEL PACK INTERVALS: From **20** ft. to **158** ft. From _____ ft. to _____ ft.

6 GROUT MATERIAL: 1 Neat cement 2 Cement grout 3 Bentonite 4 Other
 Grout Intervals From **0** ft. to **20** ft. From _____ ft. to _____ ft.
 What is the nearest source of possible contamination:
 1 Septic tank 4 Lateral lines 7 Pit privy 10 Livestock pens 14 Abandoned water well
 2 Sewer lines 5 Cess pool 8 Sewage lagoon 11 Fuel storage 15 Oil well/ Gas well
 3 Watertight sewer lines 6 Seepage pit 9 Feedyard 12 Fertilizer storage 16 Other (specify below)
 13 Insecticide storage **none**
 Direction from well? _____ How many feet? _____

FROM	TO	CODE	LITHOLOGIC LOG	FROM	TO	PLUGGING INTERVALS
0	2		Surface	110	118	Fine to med sand
f	5		Loess	118	130	Clay & caliche
5	12		Fine to some med sand	130	156	Fine to med sd & some gravel w/
12	15		Sandstone			Clay strks
15	25		Clay & caliche	156		shale
25	45		Clay & caliche & sandstone strk			
45	50		Caliche			
50	56		Sandstone			
56	68		Sandy clay & caliche			
68	74		Fine to some med sand w/			
			Caliche strks			
74	76		Caliche			
76	89		Fine to some med sd w/clay len			
89	110		clay			

7 CONTRACTOR'S OR LANDOWNER'S CERTIFICATION: This water well was (1) constructed, (2) reconstructed, or (3) plugged under my jurisdiction and was completed on (mo/day/yr) **4-12-05** and this record is true to the best of my knowledge and belief. Kansas
 Water Well Contractor's License No. **554** This Water Well Record was completed on (mo/day/yr) **4-29-05**
 under the business name of **Woofter Pump & Well Inc.** by (signature) *Janice Woofter*

OFFICE USE ONLY

T

R

SEC