

AS 6

(per plugging record KGS/KDHE)

WATER WELL RECORD

Form WWC-5

Division of Water Resources; App. No.

1 LOCATION OF WATER WELL:	Fraction County: Sheridan SW NE ¼ NW ¼ SW ¼	Section Number 9	Township Number T 6 S	Range Number R 29 E/W
----------------------------------	--	----------------------------	---------------------------------	---------------------------------

Distance and direction from nearest town or city street address of well if located within city? **Hwy 4, Nebraska Ave, Selden, KS**

Global Positioning Systems (decimal degrees, min. of 4 digits)
 Latitude: _____
 Longitude: _____
 Elevation: **2836.5**
 Datum: **NAD 83**
 Data Collection Method: **USGS National Map**

2 WATER WELL OWNER: Home Oil
 RR#, St. Address, Box # : **Don Porsch Estate c/o Kathy Porsch**
 City, State, ZIP Code : **1629 Hillcrest Rd Lawrence, KS 66044**

3 LOCATE WELL'S LOCATION WITH AN "X" IN SECTION BOX:

N

E

S

4 DEPTH OF COMPLETED WELL .141..... ft.

Depth(s) Groundwater Encountered (1).**129**..... ft. (2)..... ft. (3)..... ft.
 WELL'S STATIC WATER LEVEL **129**..... ft. below land surface measured on mo/day/yr. **09-30-06**
 Pump test data: Well water was **140**..... ft. after **0.5**..... hours pumping **2.5**..... gpm
 Est. Yield. **2.0**..... gpm: Well water was..... ft. after..... hours pumping..... gpm

WELL WATER TO BE USED AS: 5 Public water supply 8 Air conditioning 11 Injection well
 1 Domestic 3 Feedlot 6 Oil field water supply 9 Dewatering 12 Other (Specify below)
 2 Irrigation 4 Industrial 7 Domestic (lawn & garden) 10 Monitoring well **AS-6**.....

Was a chemical/bacteriological sample submitted to Department? Yes..... No ; If yes, mo/day/yr
 Sample was submitted..... Water well disinfected? Yes..... No

5 TYPE OF CASING USED:

1 Steel	3 RMP (SR)	6 Asbestos-Cement	9 Other (specify below)	CASING JOINTS: Glued..... Clamped.....
<input checked="" type="checkbox"/> 2 PVC	4 ABS	7 Fiberglass		Welded.....

Blank casing diameter **2**..... in. to **139**..... ft., Diameter..... in. to..... ft., Diameter..... in. to..... ft.
 Casing height above land surface **4.0**..... in., Weight **0.70**..... lbs./ft. Wall thickness or gauge No. **Sch 40**

TYPE OF SCREEN OR PERFORATION MATERIAL:

1 Steel	3 Stainless Steel	5 Fiberglass	<input checked="" type="checkbox"/> 7 PVC	9 ABS	11 Other (Specify).....
2 Brass	4 Galvanized Steel	6 Concrete tile	8 RM (SR)	10 Asbestos-Cement	12 None used (open hole)

SCREEN OR PERFORATION OPENINGS ARE:

1 Continuous slot	<input checked="" type="checkbox"/> 3 Mill slot 0.0205	5 Guazed wrapped	7 Torch cut	9 Drilled holes	11 None (open hole)
2 Louvered shutter	4 Key punched	6 Wire wrapped	8 Saw Cut	10 Other (specify).....	

SCREEN-PERFORATED INTERVALS: From **139**..... ft. to **141**..... ft., From..... ft. to..... ft.
 From..... ft. to..... ft., From..... ft. to..... ft.

GRAVEL PACK INTERVALS: From **134**..... ft. to **141**..... ft., From..... ft. to..... ft.
 From..... ft. to..... ft., From..... ft. to..... ft.

6 GROUT MATERIAL: 1 Neat cement 2 Cement grout 3 Bentonite 4 Other.....

Grout Intervals: From **134**..... ft. to **0.6**..... ft., From **0.6**..... ft. to **0 concrete**..... ft., From..... ft. to..... ft.

What is the nearest source of possible contamination:


1 Septic tank	4 Lateral lines	7 Pit privy	10 Livestock pens	13 Insecticide Storage	<input checked="" type="checkbox"/> 6 Other (specify below)
2 Sewer lines	5 Cess pool	8 Sewage lagoon	11 Fuel storage	14 Abandoned water well	former fuel storage
3 Watertight sewer lines	6 Seepage pit	9 Feedyard	12 Fertilizer Storage	15 Oil well/gas well	

Direction from well? How many feet? **at source**.....

FROM	TO	LITHOLOGIC LOG	FROM	TO	PLUGGING INTERVALS
0	1	Topsoil, concrete			
1	17	Silt			
17	25	Clayey Silt			
25	35	Sandy Silt			
35	50	Silt			
50	65	Sand			
65	70	Sandy Silt			
70	100	Sand			
100	102	Clayey Silt			
102	141	Sand-Clayey Silt - Sandstone			

7 CONTRACTOR'S OR LANDOWNER'S CERTIFICATION: This water well was (1) constructed, (2) reconstructed, or (3) plugged under my jurisdiction and was completed on (mo/day/year) **09-27-06**..... and this record is true to the best of my knowledge and belief.
 Kansas Water Well Contractor's License No. **554**..... This Water Well Record was completed on (mo/day/year) **10-23-06**.....
 under the business name of **Woofter Pump & Well, Inc.** by (signature) *[Signature]*

INSTRUCTIONS: Use typewriter or ball point pen. PLEASE PRESS FIRMLY and PRINT clearly. Please fill in blanks, underline or circle the correct answers. Send top three copies to Kansas Department of Health and Environment, Bureau of Water, Geology Section, 1000 SW Jackson St., Suite 420, Topeka, Kansas 66612-1367. Telephone 785-296-5522. Send one to WATER WELL OWNER and retain one for your records. Fee **6** \$5.00 for each constructed well. Visit us at <http://www.kdhe.state.ks.us/geo/waterwells>.

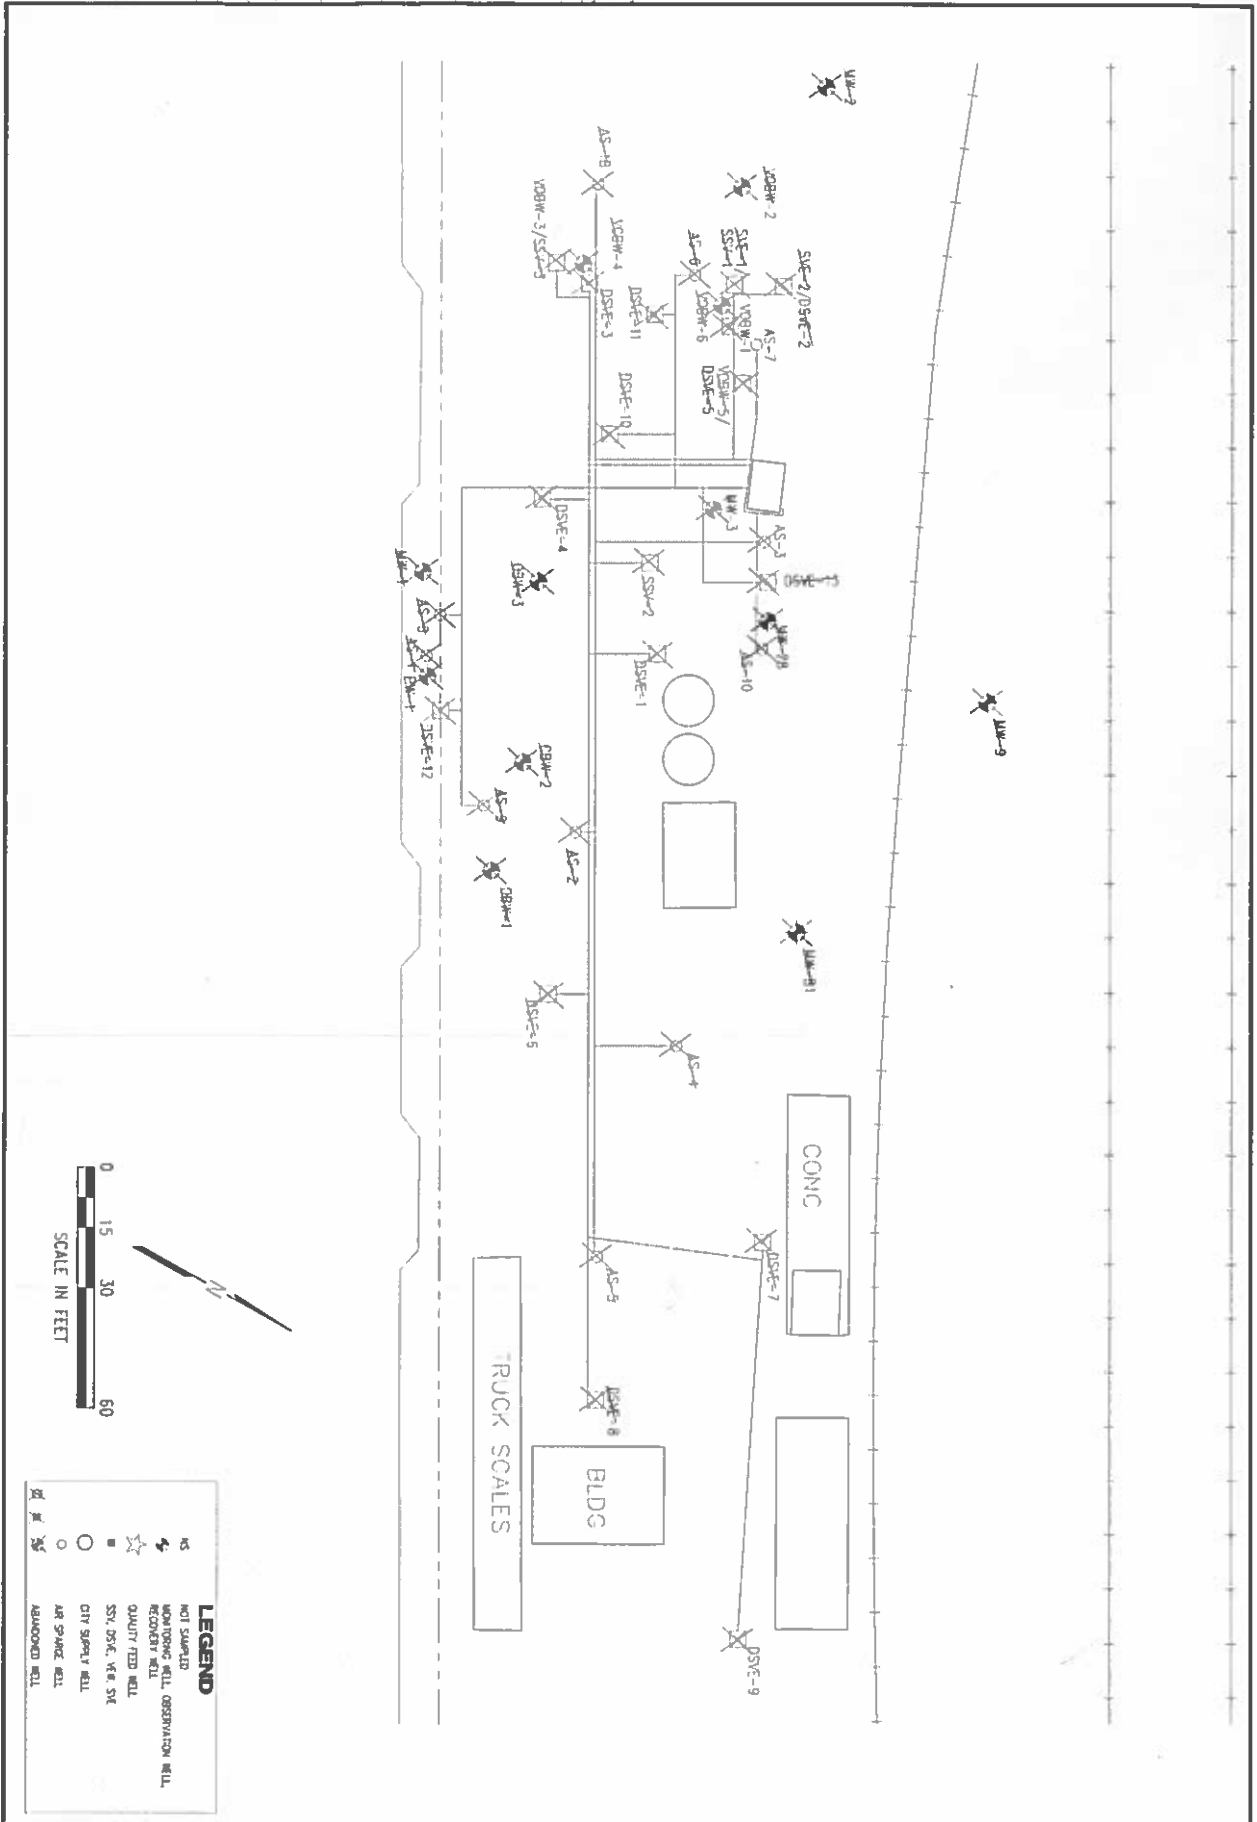

<p>LEGEND</p> <p>✕ NOT SAMPLED ✕ MONITORING WELL, OBSERVATION WELL, RECOVERY WELL ☆ QUALITY FEED WELL ■ SSN, DSAC, V&B SYE ○ CITY SUPPLY WELL ○ AIR SPARGE WELL ○ ABANDONED WELL</p>	<p>SCALE IN FEET</p> <p>0 15 30 60</p>	<p>FIGURE 1</p>