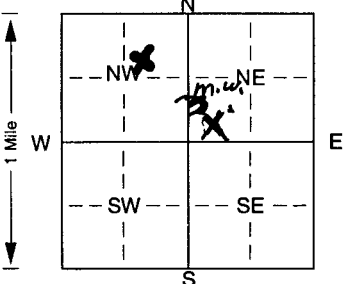


1 LOCATION OF WATER WELL: Fraction SE 1/4 NE 1/4 NW 1/4 Section Number 17 Township Number T 06 S Range Number R 29 E
 County: Sheridan

Distance and direction from nearest town or city street address of well if located within city?
3 miles wrst of Selden KS

2 WATER WELL OWNER: Abriance LLC - Attn: Roy Becken
 RR#, St. Address, Box #: MS 301 Board of Agriculture, Division of Water Resources
 City, State, ZIP Code: P.O. Box 64089 St. Paul MN, 55164-0089 Application Number:

3 LOCATE WELL'S LOCATION WITH AN "X" IN SECTION BOX:

 4 DEPTH OF COMPLETED WELL: 160 ft. ELEVATION: NA
 Depth(s) Groundwater Encountered 1. 135.0 ft. 2. ft. 3. ft.
 WELL'S STATIC WATER LEVEL: 138.9 ft. below land surface measured on mo/day/yr
 Pump test data: Well water was ft. after hours pumping gpm
 Est. Yield gpm: Well water was ft. after hours pumping gpm
 Bore Hole Diameter: 8.25 in. to ft., and in. to ft.
 WELL WATER TO BE USED AS: 5 Public water supply 8 Air conditioning 11 Injection well
 1 Domestic 3 Feedlot 6 Oil field water supply 9 Dewatering 12 Other (Specify below)
 2 Irrigation 4 Industrial 7 Domestic (lawn & garden) 10 Monitoring well
 Was a chemical/bacteriological sample submitted to Department? Yes. No ; If yes, mo/day/yr sample was sub-
 mitted Water Well Disinfected? Yes No

5 TYPE OF BLANK CASING USED: 5 Wrought iron 8 Concrete tile CASING JOINTS: Glued. Clamped.
 1 Steel 3 RMP (SR) 6 Asbestos-Cement 9 Other (specify below) Welded
2 PVC 4 ABS 7 Fiberglass Threaded
 Blank casing diameter: 2.0 in. to 145.0 ft., Dia in. to ft., Dia in. to ft.
 Casing height above land surface: 0.0 in., weight lbs./ft. Wall thickness or gauge No. Schedule 80
 TYPE OF SCREEN OR PERFORATION MATERIAL: 7 PVC 10 Asbestos-cement
 1 Steel 3 Stainless steel 5 Fiberglass 8 RMP (SR) 11 Other (specify)
 2 Brass 4 Galvanized steel 6 Concrete tile 9 ABS 12 None used (open hole)
 SCREEN OR PERFORATION OPENINGS ARE: 5 Gauzed wrapped 8 Saw cut 11 None (open hole)
 1 Continuous slot 3 Mill slot 6 Wire wrapped 9 Drilled holes
 2 Louvered shutter 4 Key punched 7 Torch cut 10 Other (specify) ft.
 SCREEN-PERFORATED INTERVALS: From 145.0 ft. to 160.0 ft., From ft. to ft.
 GRAVEL PACK INTERVALS: From 135.0 ft. to 160.0 ft., From ft. to ft.
 From ft. to ft., From ft. to ft.

6 GROUT MATERIAL: 1 Neat cement 2 Cement grout 3 Bentonite 4 Other 3/8 Bent. Pellets
 Grout Intervals: From 0.0 ft. to 132.0 ft., From 132.0 ft. to 135.0 ft., From ft. to ft.
 What is the nearest source of possible contamination:
 1 Septic tank 4 Lateral lines 7 Pit privy 10 Livestock pens 14 Abandoned water well
 2 Sewer lines 5 Cess pool 8 Sewage lagoon 11 Fuel storage 15 Oil well/Gas well
 3 Watertight sewer lines 6 Seepage pit 9 Feedyard 12 Fertilizer storage 16 Other (specify below)
 13 Insecticide storage
 Direction from well? How many feet?

FROM	TO	LITHOLOGIC LOG	FROM	TO	PLUGGING INTERVALS
0.0	1.0	Top soil, black, clay w silt, moist			
1.0	18.0	Silt, firm, dry, Gray, trace of sand			
18.0	28.0	Silt, firm, gray, trace of sand			
28.0	50.0	Fine to medium sand, brown, dry			
50.0	70.0	Sand, loose, brown, fine to medium			
70.0	93.0	Clay silt, with trace sand, brown dry			
93.0	103.0	Silt, Red, some clay, moist			
103.0	118.0	Fine grained sand, light brown, gravel			
118.0	123.0	Sandy clay w silt, brown, mottled white			
123.0	138.0	Clay, sand, mottled brown, fine sand			
138.0	160.0	Silty sand, brown, dry, hard, gravel & sand			

**Original Returned to Sender
 for Correction Date: 8/23/10**

7 CONTRACTOR'S OR LANDOWNER'S CERTIFICATION: This water well was (1) constructed, (2) reconstructed, or (3) plugged under my jurisdiction and was completed on (mo/day/year) 5-14-2010 and this record is true to the best of my knowledge and belief. Kansas Water Well Contractor's Licence No. 694 This Water Well Record was completed on (mo/day/yr) 6-24-2010 under the business name of HWS Consulting by (signature) Robert J. Mauer