

WATER WELL PLUGGING RECORD Form WWC-5P

KSA 82a-1212

ID NO.


SSV-2

1 LOCATION OF WATER WELL: Fraction ¼ SE ¼ NW ¼ SW ¼ Section Number 9 Township Number T 6 S Range Number 29 E W
 County: Sheridan

Street/Rural Address of Well Location; if unknown, distance & direction from nearest town or intersection: If at owner's address, check here Nebraska Avenue and Hwy 83

Global Positioning Systems (GPS) information:
 Latitude: _____ (in decimal degrees)
 Longitude: _____ (in decimal degrees)
 Elevation: _____
 Horizontal Datum: WGS84, NAD83, NAD27
 Collection Method:
 GPS unit (Make/Model: _____)
 Digital Map/Photo, Topographic Map, Land Survey
 Est. Accuracy: < 3 m, 3-5 m, 5-15 m, > 15 m

2 WATER WELL OWNER: Don Porsch (deceased)
 RR#, St. Address, Box #:
 City, State ZIP Code: Selden, KS 67557

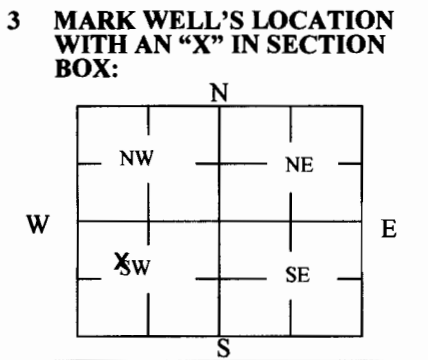

4 DEPTH OF WELL 54.90 ft.
 WELL'S STATIC WATER LEVEL DRY ft
 WELL WAS USED AS:
 Domestic Public Water Supply Dewatering
 Irrigation Oil Field Water Supply Monitoring
 Feedlot Domestic (Lawn & Garden) Injection Well
 Industrial Air Conditioning Other Remedial Well SSV-2
 Was a chemical/bacteriological sample submitted to Department? Yes No


5 TYPE OF BLANK CASING USED:
 Steel RMP (SR) Wrought Fiberglass Other (Specify below)
 PVC ABS Asbestos-Cement Concrete Tile
 Blank casing diameter 2 in. Was casing pulled? Yes No If yes, how much 3'
 Casing height above or below land surface -36 in.

6 GROUT PLUG MATERIAL: Neat cement Cement grout Bentonite Other _____
 Grout Plug Intervals: From 3 ft. to 54.90 ft., From _____ ft. to _____ ft., From _____ ft. to _____ ft.
 What is the nearest source of possible contamination:
 Septic tank Seepage pit Fuel storage Other (specify below)
 Sewer lines Pit privy Fertilizer storage
 Watertight sewer lines Sewage lagoon Insecticide storage
 Lateral lines Feedyard Abandoned water well Direction from well? _____
 Cess pool Livestock pens Oil well/Gas well How many feet? _____

FROM	TO	PLUGGING MATERIALS	FROM	TO	PLUGGING MATERIALS
0	3	Native Soil			Notes:
3	54.90	Bentonite Grout			Home Oil Bulk Plant: U6-090-00221

7 CONTRACTOR'S OR LANDOWNER'S CERTIFICATION: This water well was plugged under my jurisdiction and was completed on (mo/day/year) 8/31/17 and this record is true to the best of my knowledge and belief. Kansas Water Well Contractor's License No. 735. This Water Well Record was completed on (mo/day/year) 11/9/17 under the business name of MILCO Environmental Services, Inc. by (signature) *[Signature]*

Send one white copy to Kansas Department of Health & Environment, Geology Section, 1000 SW Jackson Street, Ste. 420, Topeka, KS 66612-1367. Send one copy to WATER WELL OWNER and retain one for your records.
 Visit us at <http://www.kdheks.gov/waterwell/index.html> Telephone 785-296-5524.

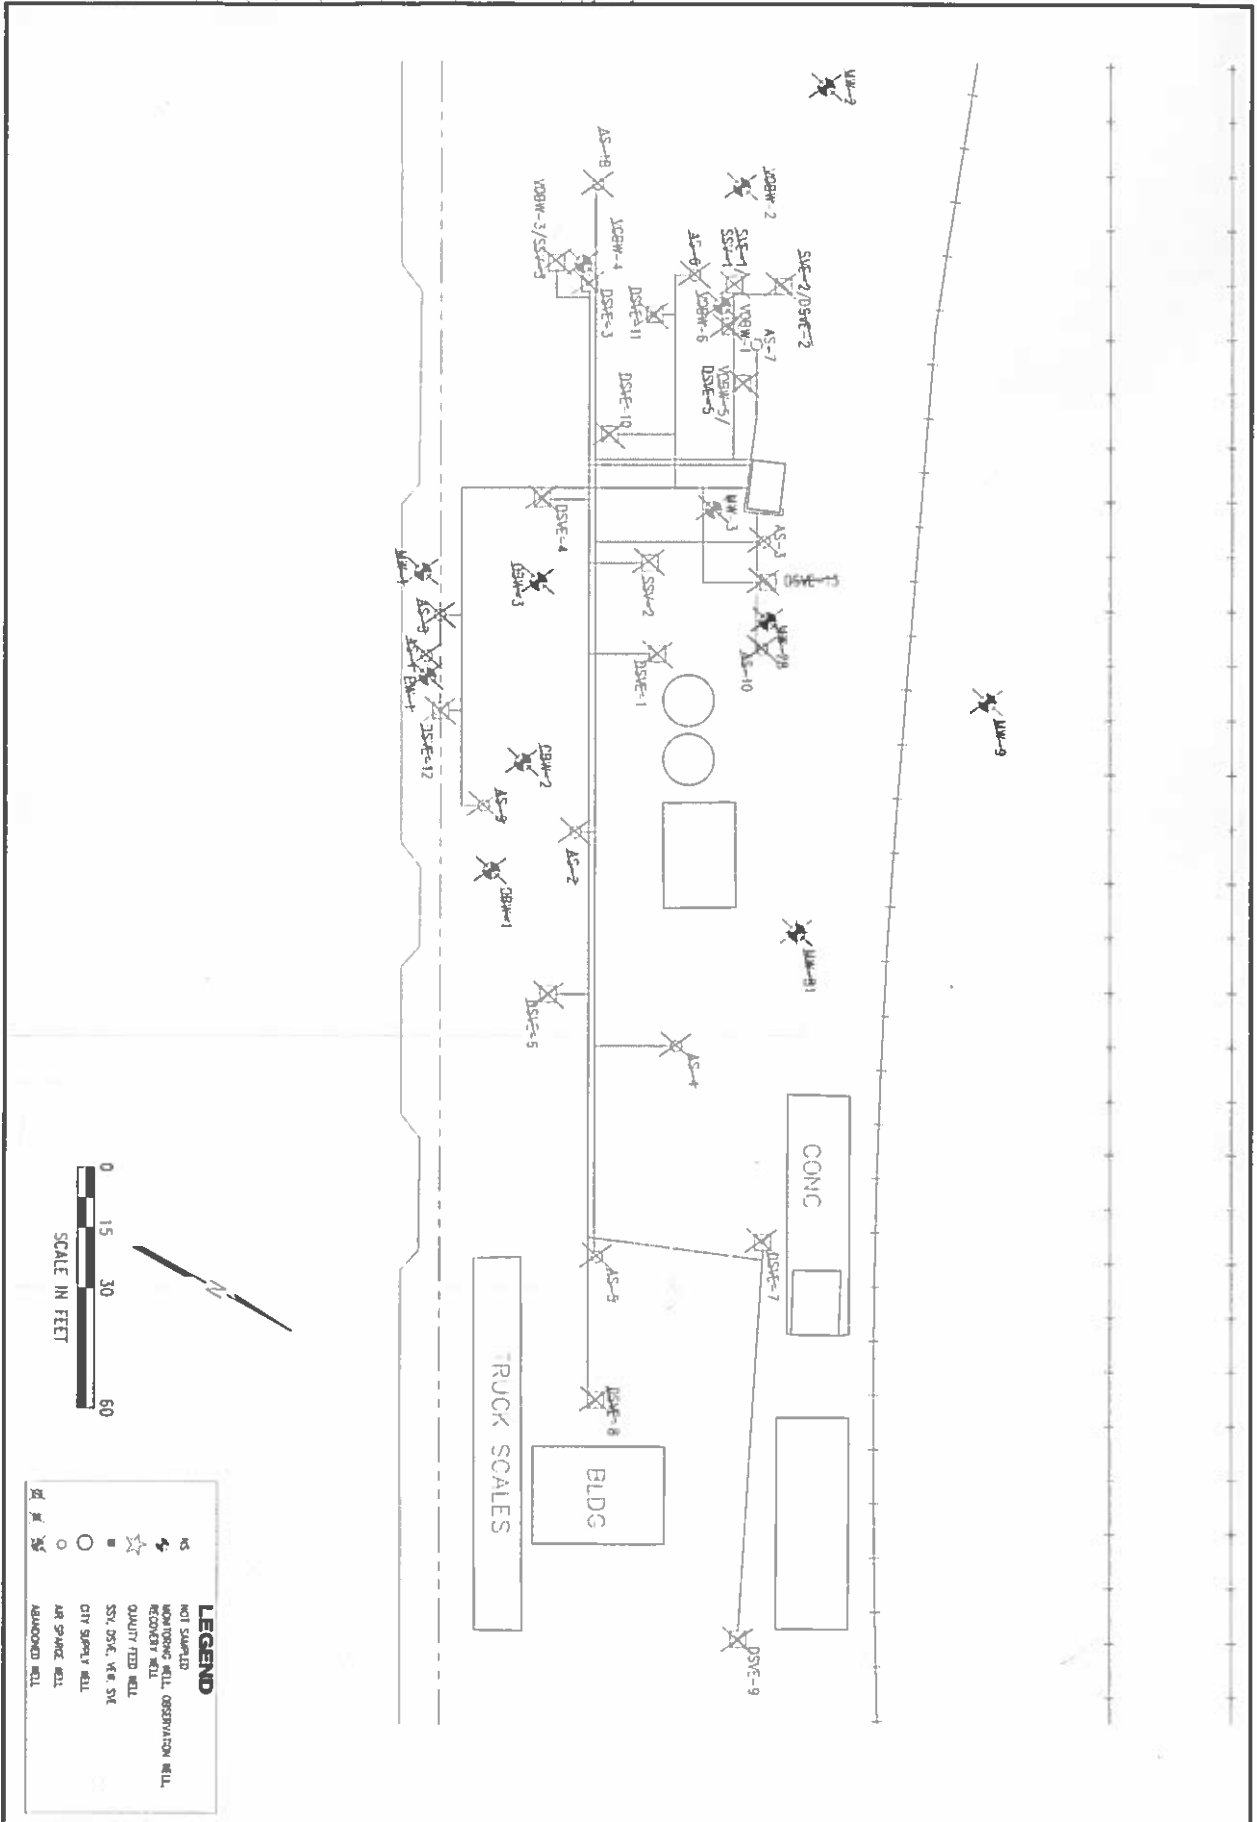

<p>LEGEND</p> <ul style="list-style-type: none"> AS NOT SAMPLED MONITORING WELL, OBSERVATION WELL RECOVERY WELL QUALITY FEED WELL SSW, DSW, V&B SW CITY SUPPLY WELL AIR SPARGE WELL ADVANCED WELL 	<p>HOME OIL REMEDIAL SITE MAP SELDEN, KANSAS U6-090-221</p>	<p>MILCO Environmental Services, Inc. 1000 W. 12th St. Selden, KS 67357-1411</p>
<p>DATE: 01/19/2010 DRAWN BY: JLD CHECKED BY: JLD SCALE: 1" = 30'</p>	<p>This document, and the data and design developed herein, are the property of remedial services, in the capacity of S&B & Associates and shall not be used in whole or in part, for any other project without the written authorization of S&B & Associates.</p>	