

WATER WELL PLUGGING RECORD Form WWC-5P

KSA 82a-1212

ID NO.

DSVE-3


1 LOCATION OF WATER WELL: Fraction ¼ SE ¼ NW ¼ SW ¼ Section Number 9 Township Number T 6 S Range Number 29 E W
 County: Sheridan

Street/Rural Address of Well Location; if unknown, distance & direction from nearest town or intersection: If at owner's address, check here Nebraska Avenue and Hwy 83

Global Positioning Systems (GPS) information:
 Latitude: _____ (in decimal degrees)
 Longitude: _____ (in decimal degrees)
 Elevation: _____
 Horizontal Datum: WGS84, NAD83, NAD27
 Collection Method: _____

2 WATER WELL OWNER: Don Porsch (deceased)
 RR#, St. Address, Box #:
 City, State ZIP Code: Selden, KS 67557

GPS unit (Make/Model: _____)
 Digital Map/Photo, Topographic Map, Land Survey
 Est. Accuracy: < 3 m, 3-5 m, 5-15 m, > 15 m

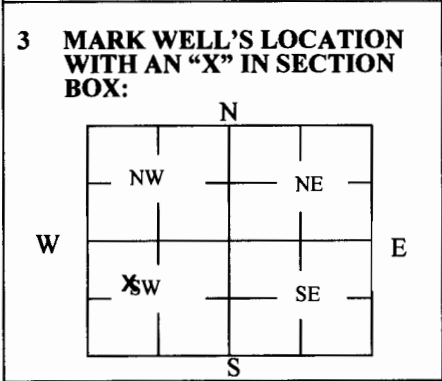

4 DEPTH OF WELL 124.15 ft.
 WELL'S STATIC WATER LEVEL DRY ft
 WELL WAS USED AS:
 Domestic Public Water Supply Dewatering
 Irrigation Oil Field Water Supply Monitoring
 Feedlot Domestic (Lawn & Garden) Injection Well
 Industrial Air Conditioning Other Remedial Well
 Was a chemical/bacteriological sample submitted to Department? Yes No **DSVE-3**


5 TYPE OF BLANK CASING USED:
 Steel RMP (SR) Wrought Fiberglass Other (Specify below)
 PVC ABS Asbestos-Cement Concrete Tile
 Blank casing diameter 4 in. Was casing pulled? Yes No If yes, how much _____
 Casing height above or below land surface >-12 in.

6 GROUT PLUG MATERIAL: Neat cement Cement grout Bentonite Other _____
 Grout Plug Intervals: From 4 ft. to 124.15 ft., From _____ ft. to _____ ft., From _____ ft. to _____ ft.
 What is the nearest source of possible contamination:
 Septic tank Seepage pit Fuel storage Other (specify below)
 Sewer lines Pit privy Fertilizer storage
 Watertight sewer lines Sewage lagoon Insecticide storage
 Lateral lines Feedyard Abandoned water well Direction from well? _____
 Cess pool Livestock pens Oil well/Gas well How many feet? _____

FROM	TO	PLUGGING MATERIALS	FROM	TO	PLUGGING MATERIALS
0	1	Asphalt			Notes: Well vault & pad were left in place, approx. 1' bgs per Pam Chaffee/BOW approval
1	4	Native Soil			
4	124.15	Bentonite Grout			
					Home Oil Bulk Plant: U6-090-00221

7 CONTRACTOR'S OR LANDOWNER'S CERTIFICATION: This water well was plugged under my jurisdiction and was completed on (mo/day/year) 8/31/17 and this record is true to the best of my knowledge and belief. Kansas Water Well Contractor's License No. 735. This Water Well Record was completed on (mo/day/year) 11/9/17 under the business name of MILCO Environmental Services, Inc. by (signature) *[Signature]*

Send one white copy to Kansas Department of Health & Environment, Geology Section, 1000 SW Jackson Street, Ste. 420, Topeka, KS 66612-1367. Send one copy to WATER WELL OWNER and retain one for your records.
 Visit us at <http://www.kdheks.gov/waterwell/index.html> Telephone 785-296-5524.

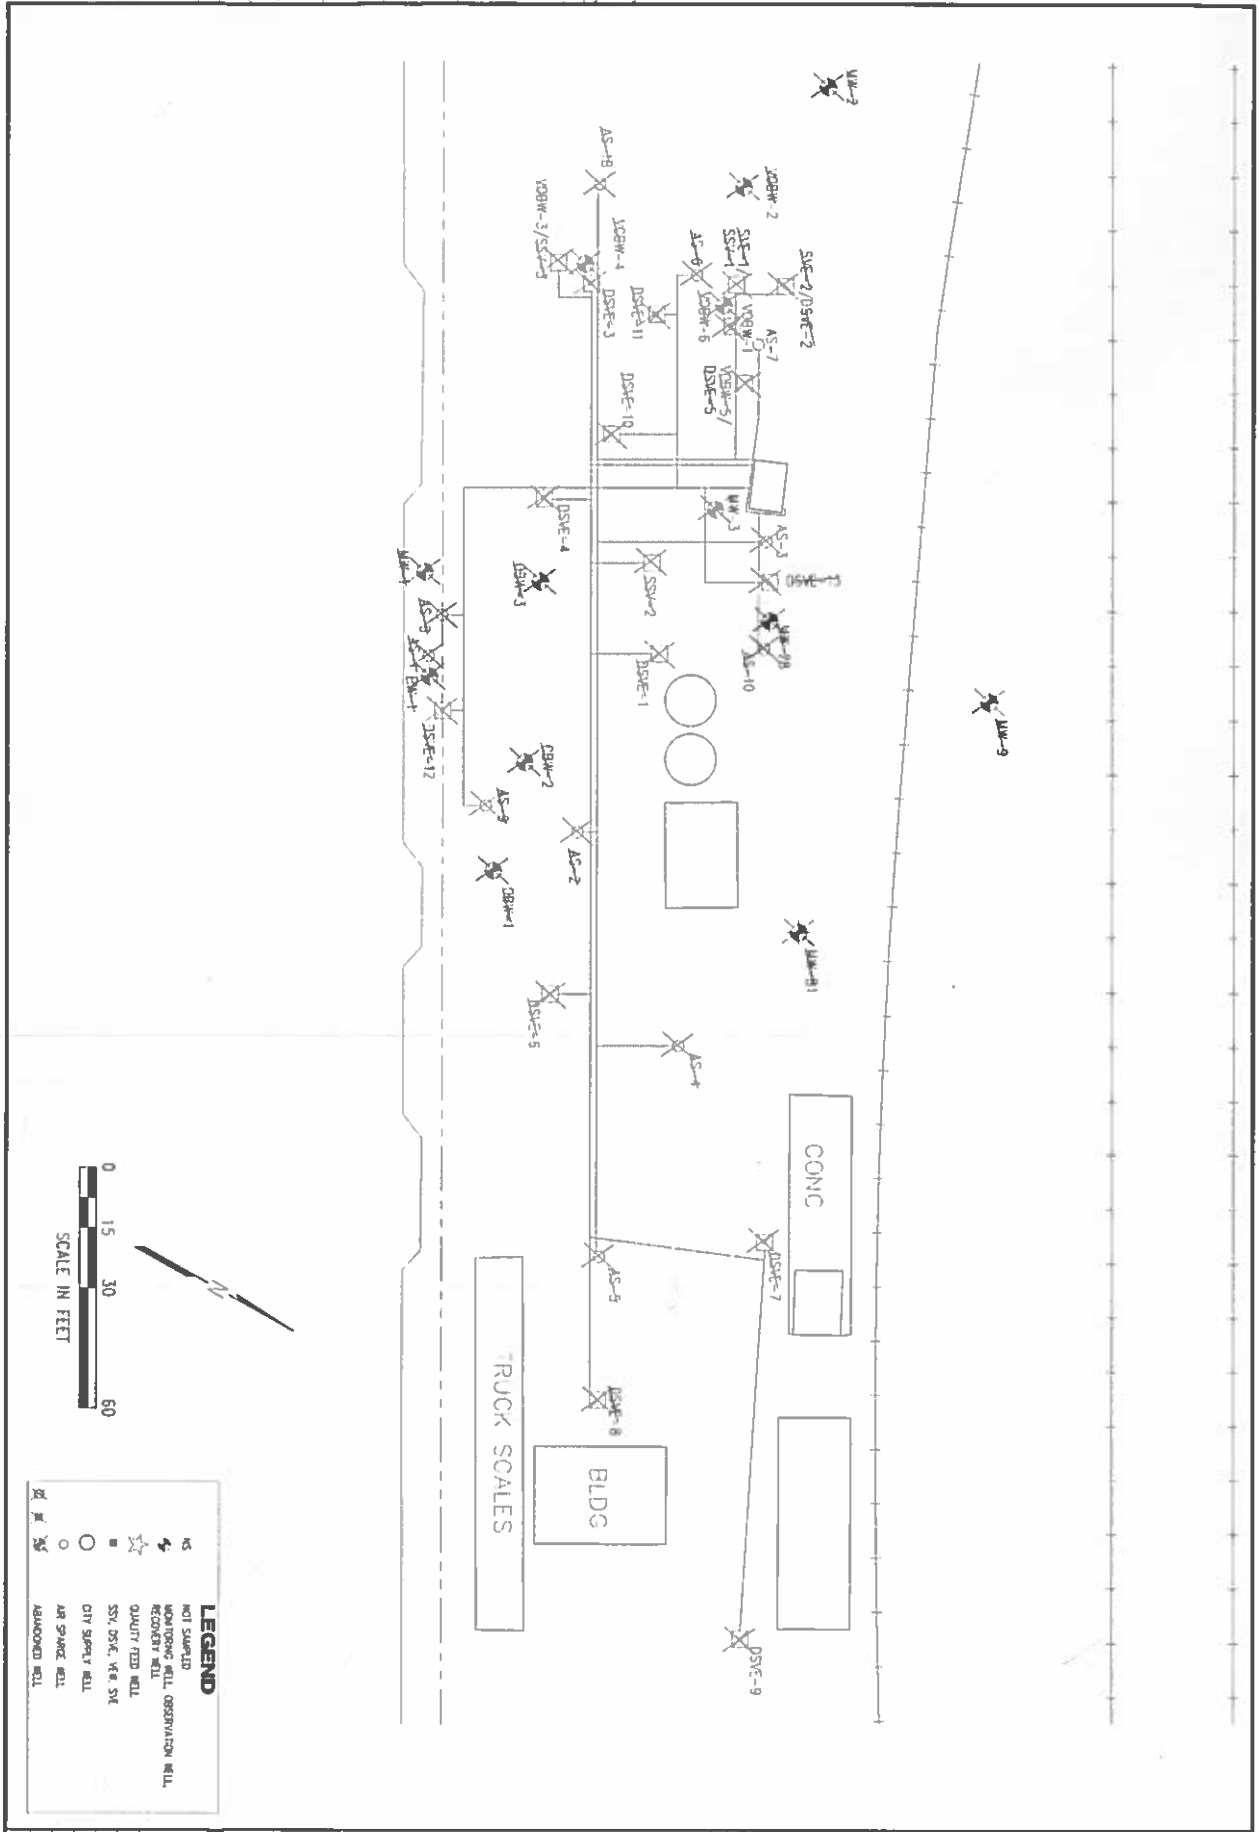

LEGEND

✱	NOT SAMPLED
✱	MONITORING WELL, OBSERVATION WELL
✱	RECOVERY WELL
✱	QUALITY FEED WELL
✱	SSV, DSVC, VOB SVK
○	CITY SUPPLY WELL
○	AIR SPARGE WELL
○	ABANDONED WELL

DATE: 01-19-2010
 PROJECT NO: 258P1001
 SHEET NO: 10
 SCALE: AS SHOWN

**HOME OIL
 REMEDIAL SITE MAP
 SELDEN, KANSAS U6-090-221**

MILCO
 Environmental Services, Inc.
