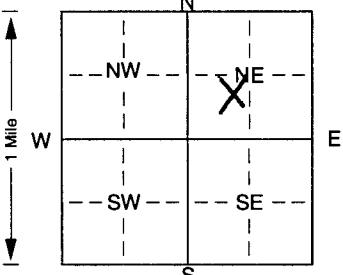


1 LOCATION OF WATER WELL: Fraction NE SE NW SE Section Number 5 Township Number T 6 S Range Number R 3 E/W
 County: Cloud NE 1/4 SW 1/4 NE 1/4

Distance and direction from nearest town or city street address of well if located within city?
1306 Country Club, Concordia, Kansas

2 WATER WELL OWNER: Don Kling
 RR#, St. Address, Box #: 611 E. 13th Board of Agriculture, Division of Water Resources
 City, State, ZIP Code: Concordia, KS 66901 Application Number:

3 LOCATE WELL'S LOCATION WITH AN "X" IN SECTION BOX:

 4 DEPTH OF COMPLETED WELL: 220 ft. ELEVATION:
 Depth(s) Groundwater Encountered 1. ft. 2. ft. 3. ft.
 WELL'S STATIC WATER LEVEL ft. below land surface measured on mo/day/yr
 Pump test data: Well water was ft. after hours pumping gpm
 Est. Yield gpm: Well water was ft. after hours pumping gpm
 Bore Hole Diameter: 8 in. to 220 ft., and in. to ft.
 WELL WATER TO BE USED AS: 5 Public water supply 8 Air conditioning 11 Injection well
 1 Domestic 3 Feedlot 6 Oil field water supply 9 Dewatering 12 Other (Specify below)
 2 Irrigation 4 Industrial 7 Domestic (lawn & garden) 10 Monitoring well
 Was a chemical/bacteriological sample submitted to Department? Yes. No. ; If yes, mo/day/yrs sample was submitted
 Water Well Disinfected? Yes No

5 TYPE OF BLANK CASING USED:
 1 Steel 3 RMP (SR) 6 Asbestos-Cement 9 Other (specify below) Welded
2 PVC 4 ABS 7 Fiberglass Threaded
 Blank casing diameter 5 in. to 160 ft., Dia in. to ft., Dia in. to ft.
 Casing height above land surface: ≈ 24 in., weight lbs./ft. Wall thickness or gauge No.
 TYPE OF SCREEN OR PERFORATION MATERIAL:
 1 Steel 3 Stainless steel 5 Fiberglass 7 PVC 10 Asbestos-cement
 2 Brass 4 Galvanized steel 6 Concrete tile 8 RMP (SR) 11 Other (specify)
 9 ABS 12 None used (open hole)
 SCREEN OR PERFORATION OPENINGS ARE:
 1 Continuous slot 3 Mill slot 5 Gauzed wrapped 8 Saw cut 11 None (open hole)
 2 Louvered shutter 4 Key punched 6 Wire wrapped 9 Drilled holes
 7 Torch cut 10 Other (specify) ft.
 SCREEN-PERFORATED INTERVALS: From: 160 ft. to 220 ft., From ft. to ft.
 From: ft. to ft., From ft. to ft.
 GRAVEL PACK INTERVALS: From: 20 ft. to 140 ft., From 145 ft. to 222 ft.
 From: ft. to ft., From ft. to ft.

6 GROUT MATERIAL: 1 Neat cement 2 Cement grout 3 Bentonite 4 Other
 Grout Intervals: From: 0 ft. to 20 ft., From 140 ft. to 145 ft., From ft. to ft.
 What is the nearest source of possible contamination:
 1 Septic tank 4 Lateral lines 7 Pit privy 11 Fuel storage 15 Oil well/Gas well
 2 Sewer lines 5 Cess pool 8 Sewage lagoon 12 Fertilizer storage 16 Other (specify below)
 3 Watertight sewer lines 6 Seepage pit 9 Feedyard 13 Insecticide storage Unknown
 Direction from well? How many feet?

FROM	TO	LITHOLOGIC LOG	FROM	TO	PLUGGING INTERVALS
0	24	Clay Tan			
24	45	Clay (Shale), Gray, Yellow, weathered			
45	95	Shale/Sandstone (50/50), Yellow, weathered			
95	97	Rock, Red, hard			
97	160	Clay, Red-Gray-Brown			
160	190	Clay, Red-Gray Brown, w/ sandstone			
190	220	Sandstone, Yellow-Brown, some clay lenses			

7 CONTRACTOR'S OR LANDOWNER'S CERTIFICATION: This water well was (1) constructed, (2) reconstructed, or (3) plugged under my jurisdiction and was completed on (mo/day/year) 8/14/00 and this record is true to the best of my knowledge and belief. Kansas Water Well Contractor's Licence No. 527 This Water Well Record was completed on (mo/day/yr) 8/22/00 under the business name of GeoCore Services, Inc. by (signature) Dab a bll

INSTRUCTIONS: Use typewriter or ball point pen. PLEASE PRESS FIRMLY and PRINT clearly. Please fill in blanks, underline or circle the correct answers. Send top three copies to Kansas Department of Health and Environment, Bureau of Water, Topeka, Kansas 66620-0001. Telephone 785-296-5524. Send one to WATER WELL OWNER and retain one for your records. Fee of \$5.00 for each constructed well.