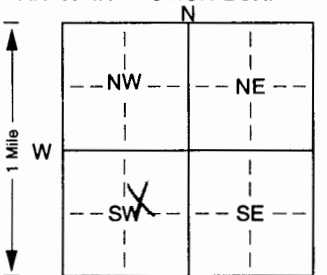


1 LOCATION OF WATER WELL: Fraction SW 1/4 NE 1/4 SW 1/4 Section Number 4 Township Number T 6 S Range Number R 3 EW
 County: Cloud
 Distance and direction from nearest town or city street address of well if located within city?
118 E. 19th Concordia Kansas

2 WATER WELL OWNER: Richard Leoffler
 RR#, St. Address, Box #: 118 E. 19th Board of Agriculture, Division of Water Resources
 City, State, ZIP Code: Concordia Kansas 66601 Application Number:

3 LOCATE WELL'S LOCATION WITH AN "X" IN SECTION BOX:

 4 DEPTH OF COMPLETED WELL: 70 ft. ELEVATION:
 Depth(s) Groundwater Encountered 1. ft. 2. ft. 3. ft.
 WELL'S STATIC WATER LEVEL ft. below land surface measured on mo/day/yr
 Pump test data: Well water was ft. after hours pumping gpm
 Est. Yield gpm: Well water was ft. after hours pumping gpm
 Bore Hole Diameter: 8 in. to 7.5 in. and in. to ft.
 WELL WATER TO BE USED AS: 5 Public water supply 8 Air conditioning 11 Injection well
 1 Domestic 3 Feedlot 6 Oil field water supply 9 Dewatering 12 Other (Specify below)
 2 Irrigation 4 Industrial 7 Domestic (lawn & garden) 10 Monitoring well
 Was a chemical/bacteriological sample submitted to Department? Yes. No. ; If yes, mo/day/yr sample was sub-
 mitted Water Well Disinfected? Yes No

5 TYPE OF BLANK CASING USED: 5 Wrought iron 8 Concrete tile CASING JOINTS: Glued. Clamped.
 1 Steel 3 RMP (SR) 6 Asbestos-Cement 9 Other (specify below) Welded
2 PVC 4 ABS 7 Fiberglass Threaded.
 Blank casing diameter . . . 5 in. to 30 ft., Dia. 5 in. to 7.5 ft., Dia in. to ft.
 Casing height above land surface. ~24 in., weight lbs./ft. Wall thickness or gauge No.
 TYPE OF SCREEN OR PERFORATION MATERIAL: 7 PVC 10 Asbestos-cement
 1 Steel 3 Stainless steel 5 Fiberglass 8 RMP (SR) 11 Other (specify)
 2 Brass 4 Galvanized steel 6 Concrete tile 9 ABS 12 None used (open hole)
 SCREEN OR PERFORATION OPENINGS ARE: 5 Gauzed wrapped 8 Saw cut 11 None (open hole)
 1 Continuous slot 3 Mill slot 6 Wire wrapped 9 Drilled holes
 2 Louvered shutter 4 Key punched 7 Torch cut 10 Other (specify) ft.
 SCREEN-PERFORATED INTERVALS: From 30 ft. to 70 ft., From ft. to ft.
 From ft. to ft., From ft. to ft.
 GRAVEL PACK INTERVALS: From 20 ft. to 7.5 ft., From ft. to ft.
 From ft. to ft., From ft. to ft.

6 GROUT MATERIAL: 1 Neat cement 2 Cement grout 3 Bentonite 4 Other
 Grout Intervals: From 0 ft. to 20 ft., From ft. to ft., From ft. to ft.
 What is the nearest source of possible contamination:
 1 Septic tank 4 Lateral lines 7 Pit privy 10 Livestock pens 14 Abandoned water well
 2 Sewer lines 5 Cess pool 8 Sewage lagoon 11 Fuel storage 15 Oil well/Gas well
 3 Watertight sewer lines 6 Seepage pit 9 Feedyard 12 Fertilizer storage 16 Other (specify below)
 13 Insecticide storage unknown
 Direction from well? How many feet?

| FROM | TO | LITHOLOGIC LOG | FROM | TO | PLUGGING INTERVALS |
|-----------|-----------|--|------|----|--------------------|
| <u>0</u> | <u>11</u> | <u>Clay, brown, very silty</u> | | | |
| <u>11</u> | <u>25</u> | <u>Clay, light brown, very silty</u> | | | |
| <u>25</u> | <u>31</u> | <u>Silt, brown, slightly clayey, with sandstone</u> | | | |
| <u>31</u> | <u>57</u> | <u>Sandstone, dark brown to brown, very friable, very fine grained</u> | | | |
| <u>57</u> | <u>59</u> | <u>Shale, gray, weathered</u> | | | |
| <u>59</u> | <u>70</u> | <u>Sandstone, dark brown to brown, very friable, very fine, interbedded shale layers</u> | | | |
| <u>70</u> | <u>75</u> | <u>Shale, gray, weathered w/ sandstone interbedded sandstone layers</u> | | | |

7 CONTRACTOR'S OR LANDOWNER'S CERTIFICATION: This water well was (1) constructed, (2) reconstructed, or (3) plugged under my jurisdiction and was completed on (mo/day/year) . . . 10/12/00 and this record is true to the best of my knowledge and belief. Kansas Water Well Contractor's Licence No. . . . 527 This Water Well Record was completed on (mo/day/yr) . . . 10/24/00 under the business name of GeoCore Services, Inc. by (signature) Dale Relf