WATER WELL RECORD Form WWC-5 KSA 82a-1212 ID No. _____

1 LOCATION OF WATER WELL:	Fraction	Section Number	Township Number	Range Number
County: Cloud	near ¼ center ¼ SE ¼	5	T 6 S	R 3 X E/W

Distance and direction from nearest town or city street address of well if located within city?
1/4 mile West of Concordia, KS

2 WATER WELL OWNER: Dan Koch
RR#, St. Address, Box # : 1710 Republican
City, State, ZIP Code : Concordia, KS 66901

Board of Agriculture, Division of Water Resources
Application Number:

3 LOCATE WELL'S LOCATION WITH AN "X" IN SECTION BOX:

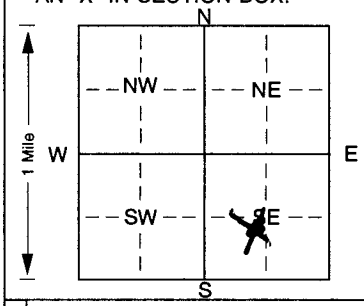

4 DEPTH OF COMPLETED WELL....123..... ft. ELEVATION:.....
Depth(s) Groundwater Encountered 1.....ft. 2.....ft. 3.....ft.
WELL'S STATIC WATER LEVEL..48..... ft. below land surface measured on mo/day/yr .....5/26/01.....
Pump test data: Well water was .....ft. after ..... hours pumping ..... gpm
Est. Yield .....gpm: Well water was .....ft. after ..... hours pumping ..... gpm
Bore Hole Diameter....10..... in. to ...123.....ft., and.....in. to .....ft.
WELL WATER TO BE USED AS: 5 Public water supply 8 Air conditioning 11 Injection well
X Domestic 3 Feedlot 6 Oil field water supply 9 Dewatering 12 Other (Specify below)
2 Irrigation 4 Industrial 7 Domestic (lawn & garden) 10 Monitoring well .....
Was a chemical/bacteriological sample submitted to Department? Yes..... No...X..; If yes, mo/day/yrs sample was submitted
Water Well Disinfected? Yes X No

5 TYPE OF BLANK CASING USED: 5 Wrought iron 8 Concrete tile CASING JOINTS: Glued...X...Clamped.....
1 Steel 3 RMP (SR) 6 Asbestos-Cement 9 Other (specify below) Welded.....
X PVC 4 ABS 7 Fiberglass ..... Threaded.....
Blank casing diameter....5.....in. to ...103.....ft., Dia .....in. to .....ft., Dia .....in. to .....ft.
Casing height above land surface....12..... in., weight .....2.37..... lbs./ft. Wall thickness or gauge No....,214.....
TYPE OF SCREEN OR PERFORATION MATERIAL: X PVC 10 Asbestos-cement
1 Steel 3 Stainless steel 5 Fiberglass 8 RMP (SR) 11 Other (specify).....
2 Brass 4 Galvanized steel 6 Concrete tile 9 ABS 12 None used (open hole)
SCREEN OR PERFORATION OPENINGS ARE: 5 Gauzed wrapped 8 Saw cut 11 None (open hole)
1 Continuous slot X Mill slot 6 Wire wrapped 9 Drilled holes
2 Louvered shutter 4 Key punched 7 Torch cut 10 Other (specify).....ft.
SCREEN-PERFORATED INTERVALS: From.....103..... ft. to ...123..... ft., From ..... ft. to..... ft.
From..... ft. to ..... ft., From ..... ft. to..... ft.
GRAVEL PACK INTERVALS: From.....26..... ft. to ...123..... ft., From ..... ft. to..... ft.
From..... ft. to ..... ft., From ..... ft. to..... ft.

6 GROUT MATERIAL: 1 Neat cement 2 Cement grout X Bentonite 4 Other .....
Grout Intervals: From....1..... ft. to ....26.....ft., From .....ft. to.....ft., From .....ft. to.....ft.
What is the nearest source of possible contamination: None within 1/4 mile 10 Livestock pens 14 Abandoned water well
1 Septic tank 4 Lateral lines 7 Pit privy 11 Fuel storage 15 Oil well/Gas well
2 Sewer lines 5 Cess pool 8 Sewage lagoon 12 Fertilizer storage 16 Other (specify below)
3 Watertight sewer lines 6 Seepage pit 9 Feedyard 13 Insecticide storage .....
Direction from well? How many feet?

FROM	TO	LITHOLOGIC LOG	FROM	TO	PLUGGING INTERVALS
0	8	Topsoil			
8	35	Clay, tan			
35	40	Clay, light gray			
40	52	Clay, sandy, yellow with sandstone			
		layers			
52	123	Sandstone			

7 CONTRACTOR'S OR LANDOWNER'S CERTIFICATION: This water well was (X) constructed, (2) reconstructed, or (3) plugged under my jurisdiction and was completed on (mo/day/year) ....5/29/01..... and this record is true to the best of my knowledge and belief. Kansas Water Well Contractor's Licence No. .138..... This Water Well Record was completed on (mo/day/yr) .....5/30/01.....
under the business name of Peterson Irrigation, Inc. by (signature) Mike Peterson

INSTRUCTIONS: Use typewriter or ball point pen. *PLEASE PRESS FIRMLY* and *PRINT* clearly. Please fill in blanks, underline or circle the correct answers. Send top three copies to Kansas Department of Health and Environment, Bureau of Water, Topeka, Kansas 66620-0001. Telephone 785-296-5524. Send one to WATER WELL OWNER and retain one for your records. Fee of $5.00 for each constructed well.