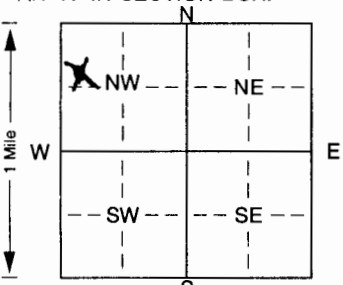


1 LOCATION OF WATER WELL: County: Cloud	Fraction SW ¼ NW ¼ NW ¼	Section Number 3	Township Number T 6 S	Range Number R 3 W
---	---	----------------------------	---------------------------------	-------------------------------------

Distance and direction from nearest town or city street address of well if located within city?

In city limits, 1317 Kile, Concordia, KS 66901

2 WATER WELL OWNER: Russ Heuer RR#, St. Address, Box # : 1317 Kile City, State, ZIP Code : Concordia, KS 66901	Board of Agriculture, Division of Water Resources Application Number:
---	--

3 LOCATE WELL'S LOCATION WITH AN "X" IN SECTION BOX: 	4 DEPTH OF COMPLETED WELL... 113 ... ft. ELEVATION:..... Depth(s) Groundwater Encountered 1..... ft. 2..... ft. 3..... ft. WELL'S STATIC WATER LEVEL... 70 ... ft. below land surface measured on mo/day/yr 7/06/01 Pump test data: Well water was ft. after hours pumping gpm Est. Yield 20 ... gpm: Well water was ft. after hours pumping gpm Bore Hole Diameter... 9 ... in. to 113 ... ft., and..... in. to ft. WELL WATER TO BE USED AS: 5 Public water supply 8 Air conditioning 11 Injection well 1 Domestic 3 Feedlot 6 Oil field water supply 9 Dewatering 12 Other (Specify below) 2 Irrigation 4 Industrial <input checked="" type="checkbox"/> Domestic (lawn & garden) 10 Monitoring well Was a chemical/bacteriological sample submitted to Department? Yes..... No <input checked="" type="checkbox"/>; If yes, mo/day/yr sample was submitted Water Well Disinfected? Yes <input checked="" type="checkbox"/> No
--	--

5 TYPE OF BLANK CASING USED: 1 Steel 3 RMP (SR) 5 Wrought iron 8 Concrete tile CASING JOINTS: Glued. <input checked="" type="checkbox"/> Clamped..... <input checked="" type="checkbox"/> PVC 4 ABS 7 Fiberglass 9 Other (specify below) Welded..... Blank casing diameter..... 5 in. to 103 ft., Dia..... in. to ft., Dia..... in. to ft. Casing height above land surface..... 12 in., weight 2.37 lbs./ft. Wall thickness or gauge No. 214 TYPE OF SCREEN OR PERFORATION MATERIAL: <input checked="" type="checkbox"/> PVC 10 Asbestos-cement 1 Steel 3 Stainless steel 5 Fiberglass 8 RMP (SR) 11 Other (specify)..... 2 Brass 4 Galvanized steel 6 Concrete tile 9 ABS 12 None used (open hole) SCREEN OR PERFORATION OPENINGS ARE: 5 Gauzed wrapped 8 Saw cut 11 None (open hole) 1 Continuous slot <input checked="" type="checkbox"/> Mill slot 6 Wire wrapped 9 Drilled holes 2 Louvered shutter 4 Key punched 7 Torch cut 10 Other (specify)..... ft. SCREEN-PERFORATED INTERVALS: From..... 103 ft. to 113 ft., From..... ft. to..... ft. GRAVEL PACK INTERVALS: From..... 23 ft. to 113 ft., From..... ft. to..... ft.

6 GROUT MATERIAL: 1 Neat cement 2 Cement grout <input checked="" type="checkbox"/> Bentonite 4 Other..... Grout Intervals: From... 2 ft. to 23 ft., From..... ft. to..... ft., From..... ft. to..... ft. What is the nearest source of possible contamination: 1 Septic tank 4 Lateral lines 7 Pit privy 10 Livestock pens 14 Abandoned water well 2 Sewer lines 5 Cess pool 8 Sewage lagoon 11 Fuel storage 15 Oil well/Gas well <input checked="" type="checkbox"/> Watertight sewer lines 6 Seepage pit 9 Feedyard 12 Fertilizer storage 16 Other (specify below) 13 Insecticide storage Direction from well? West How many feet? 100

FROM	TO	LITHOLOGIC LOG	FROM	TO	PLUGGING INTERVALS
0	4	Topsoil			
4	10	Clay, brown			
10	25	Clay, gray			
25	50	Sandstone with layers of shale			
50	113	Sandstone			
113		Hard Rock			

7 CONTRACTOR'S OR LANDOWNER'S CERTIFICATION: This water well was <input checked="" type="checkbox"/> constructed, (2) reconstructed, or (3) plugged under my jurisdiction and was completed on (mo/day/year) 7/6/01 and this record is true to the best of my knowledge and belief. Kansas Water Well Contractor's Licence No. 138 This Water Well Record was completed on (mo/day/yr) 7/16/01 under the business name of Peterson Irrigation, Inc. by (signature) <i>Mike Peterson</i>
--