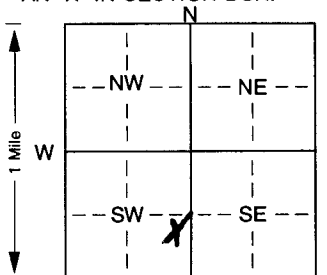


1 LOCATION OF WATER WELL: Fraction NE 1/4 SE 1/4 SW 1/4 Section Number 21 Township Number T 6 S Range Number R 3 E  
 County: Cloud  
 Distance and direction from nearest town or city street address of well if located within city? 3 miles south of Concordia KS on 81 Hwy East 1/4 mile on Noble Road then 750 North

2 WATER WELL OWNER: Justin Stahlman  
 RR#, St. Address, Box #: 1431 Noble Road Board of Agriculture, Division of Water Resources  
 City, State, ZIP Code: Concordia, KS 66901 Application Number:

3 LOCATE WELL'S LOCATION WITH AN "X" IN SECTION BOX:  DEPTH OF COMPLETED WELL: 200' ft. ELEVATION: ..... ft.  
 Depth(s) Groundwater Encountered: 1. 155' ft. 2. .... ft. 3. .... ft.  
 WELL'S STATIC WATER LEVEL: 150' ft. below land surface measured on mo/day/yr .....  
 Pump test data: Well water was ..... ft. after ..... hours pumping ..... gpm  
 Est. Yield: 7 gpm: Well water was ..... ft. after ..... hours pumping ..... gpm  
 Bore Hole Diameter: 9 in. to ..... ft., and ..... in. to ..... ft.  
 WELL WATER TO BE USED AS:  
 1 Domestic  3 Feedlot  6 Oil field water supply  9 Dewatering  12 Other (Specify below)  
 2 Irrigation  4 Industrial  7 Domestic (lawn & garden)  10 Monitoring well .....  
 Was a chemical/bacteriological sample submitted to Department? Yes. .... No. .... If yes, mo/day/yr sample was submitted  
 Water Well Disinfected:  Yes  No

5 TYPE OF BLANK CASING USED:  
 1 Steel  3 RMP (SR)  6 Asbestos-Cement  9 Other (specify below)  CASING JOINTS: Glued ..... Clamped .....  
 2 PVC  4 ABS  7 Fiberglass ..... Threaded .....  
 Blank casing diameter: 5 in. to 180 ft., Dia ..... in. to ..... ft., Dia ..... in. to ..... ft.  
 Casing height above land surface: 2' in., weight 54.40 lbs./ft. Wall thickness or gauge No. ....  
 TYPE OF SCREEN OR PERFORATION MATERIAL:  
 1 Steel  3 Stainless steel  5 Fiberglass  7 PVC  10 Asbestos-cement  
 2 Brass  4 Galvanized steel  6 Concrete tile  8 RMP (SR)  11 Other (specify) .....  
 9 ABS  12 None used (open hole)  
 SCREEN OR PERFORATION OPENINGS ARE:  
 1 Continuous slot  3 Mill slot 25, 1000's  5 Gauzed wrapped  8 Saw cut  11 None (open hole)  
 2 Louvered shutter  4 Key punched  6 Wire wrapped  9 Drilled holes ..... ft.  
 7 Torch cut  10 Other (specify) ..... ft.  
 SCREEN-PERFORATED INTERVALS: From: 180 ft. to 200 ft., From ..... ft. to ..... ft.  
 GRAVEL PACK INTERVALS: From: 25 ft. to 200 ft., From ..... ft. to ..... ft.

6 GROUT MATERIAL:  1 Neat cement  2 Cement grout  3 Bentonite  4 Other .....  
 Grout Intervals: From: 5 ft. to 25 ft., From ..... ft. to ..... ft., From ..... ft. to ..... ft.  
 What is the nearest source of possible contamination:  
 1 Septic tank  4 Lateral lines  7 Pit privy  10 Livestock pens  14 Abandoned water well  
 2 Sewer lines  5 Cess pool  8 Sewage lagoon  11 Fuel storage  15 Oil well/Gas well  
 3 Watertight sewer lines  6 Seepage pit  9 Feedyard  12 Fertilizer storage  16 Other (specify below) .....  
 Direction from well? South East How many feet? 400'

FROM	TO	LITHOLOGIC LOG	FROM	TO	PLUGGING INTERVALS
0	1	Top Soil			
1	4.5	Brown Clay			
4.5	58	Sand Stone			
58	132	Grey Shale			
132	139	Sand Stone			
139	155	Grey Shale			
155	200'	Sand Stone + limestone (water)			

7 CONTRACTOR'S OR LANDOWNER'S CERTIFICATION: This water well was  (1) constructed  (2) reconstructed, or  (3) plugged under my jurisdiction and was completed on (mo/day/year) 9/4/2002 and this record is true to the best of my knowledge and belief. Kansas Water Well Contractor's Licence No. 451 This Water Well Record was completed on (mo/day/yr) 10/14/2002 under the business name of Heldmann Well Drilling by (signature) Leigh J. Heldmann