


1 LOCATION OF WATER WELL:	Fraction	Section Number	Township Number	Range Number
County: <u>Cloud</u>	<u>SW 1/4 NW 1/4 NW 1/4</u>	<u>12</u>	<u>6</u>	<u>3 W</u>

Distance and direction from nearest town or city street address of well if located within city?
2 miles east, 1.5 miles south of Concordia at Cloud Ceramics

2 WATER WELL OWNER: <u>Cloud Ceramics</u>	Board of Agriculture, Division of Water Resources
RR #, St. Address, Box #: <u>1716 Quail Rd</u>	Application Number:
City, State, ZIP Code: <u>Concordia KS</u>	

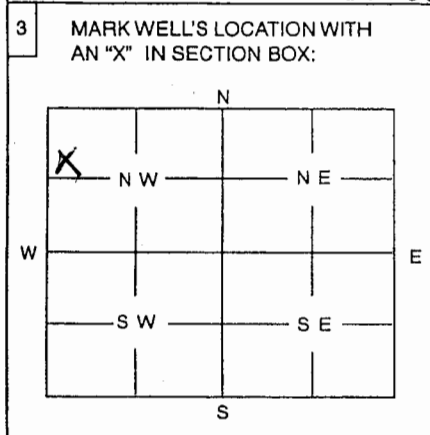

4 DEPTH OF WELL 50 ft

WELL'S STATIC WATER LEVEL ft.

WELL WAS USED AS:

1 Domestic	5 Public Water Supply	9 Dewatering
2 Irrigation	6 Oil Field Water Supply	10 Monitoring Well
3 Feedlot	7 Domestic (Lawn & Garden)	11 Injection Well
<u>4</u> Industrial	8 Air Conditioning	12 Other

Was a chemical / bacteriological sample submitted to Department? Yes No

If yes, mo/day/yr sample was submitted

Water Well Disinfected: Yes No

5 TYPE OF BLANK CASING USED:

<u>1 Steel</u>	3 RMP (SR)	5 Wrought	7 Fiberglass	9 Other (Specify below)
2 PVC	4 ABS	6 Asbestos-Cement	8 Concrete Tile	

Blank casing diameter 6 in. Was casing pulled? Yes No If yes, how much

Casing height above or below land surface in.

6 GROUT PLUG MATERIAL: 1 Neat cement 2 Cement grout 3 Bentonite 4 Other

Grout Plug Intervals: From 0 ft. to 50 ft., From ft. to ft., From to ft.

What is the nearest source of possible contamination:

1 Septic tank	6 Seepage pit	11 Fuel storage	16 Other (specify below)
2 Sewer lines	7 Pit privy	12 Fertilizer storage	
3 Watertight sewer lines	<u>8</u> Sewage lagoon	13 Insecticide storage	
4 Lateral lines	9 Feedyard	14 Abandoned water well	
5 Cess Pool	10 Livestock pens	15 Oil well/Gas well	

Direction from well? N How many feet? 260

FROM	TO	PLUGGING MATERIALS
<u>50</u>	<u>0</u>	<u>Bentonite</u>

30-40 Ft. of casing was removed prior to plugging when hill was excavated for construction project.

7 CONTRACTOR'S OR LANDOWNER'S CERTIFICATION: This water well was plugged under my jurisdiction and was completed on (mo/day/year) 7/24/97 and this record is true to the best of my knowledge and belief. Kansas Water Well Contractor's License No. 527 This Water Well Record was completed on (mo/day/year) under the business name of GeoCore by (signature) Dob Lobl

INSTRUCTIONS: Use typewriter or ball point pen. Please press firmly and print clearly. Please fill in blanks, underline or circle the correct answers. Send top three copies to Kansas Department of Health and Environment, Bureau of Water, Topeka, Kansas 66620-C Telephone: 785/296-3565. Send one to Water Well Owner and retain one for your records.