


1 LOCATION OF WATER WELL: County: Cloud Fraction: NE 1/4 SE 1/4 NW 1/4 Section Number: 4 Township Number: T 6 S Range Number: R 3 E/W

Distance and direction from nearest town or city street address of well if located within city? 1302 Lincoln, Concordia

2 WATER WELL OWNER: Mid-America Merchandising

RR#, St. Address, Box #: 204 W. Third Board of Agriculture, Division of Water Resources
City, State, ZIP Code: Kansas City, MO 64104 Application Number:

3 LOCATE WELL'S LOCATION WITH AN 'X' IN SECTION BOX:

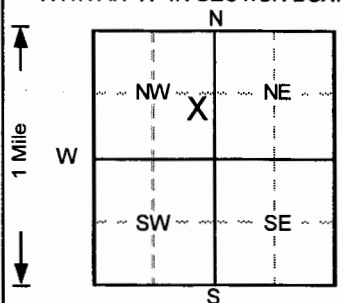

4 DEPTH OF COMPLETED WELL: 35 ft. ELEVATION: ...
Depth(s) Groundwater Encountered 1. ... ft. 2. ... ft. 3. ... ft.
WELL'S STATIC WATER LEVEL ... ft. below land surface measured on mo/day/yr ...
Pump test data: Well water was ... ft. after ... hours pumping ... gpm
Est. Yield ... gpm: Well water was ... ft. after ... hours pumping ... gpm
Bore Hole Diameter ... in. to ... ft., and ... in. to ... ft.
WELL WATER TO BE USED AS: 5 Public water supply 8 Air conditioning 11 Injection well
1 Domestic 3 Feedlot 6 Oil field water supply 9 Dewatering 12 Other (Specify below)
2 Irrigation 4 Industrial 7 Lawn and garden only 10 Monitoring well
Was a chemical/bacteriological sample submitted to Department? Yes No
Water Well Disinfected? Yes No

5 TYPE OF BLANK CASING USED: 1 Steel 3 RMP (SR) 5 Wrought iron 8 Concrete tile CASING JOINTS: Glued Clamped
2 PVC 4 ABS 6 Asbestos-Cement 9 Other (specify below) Welded
7 Fiberglass Threaded

Blank casing diameter ... in. to ... ft., Dia ... in. to ... ft., Dia ... in. to ... ft.
Casing height above land surface ... in., weight ... lbs./ft. Wall thickness or gauge No. Sch. 40

TYPE OF SCREEN OR PERFORATION MATERIAL: 1 Steel 3 Stainless steel 5 Fiberglass 7 PVC 10 Asbestos-cement
2 Brass 4 Galvanized steel 6 Concrete tile 8 RMP (SR) 11 Other (specify)
12 None used (open hole)

SCREEN OR PERFORATION OPENINGS ARE: 1 Continuous slot 3 Mill slot 5 Gauzed wrapped 8 Saw cut 11 None (open hole)
2 Louvered shutter 4 Key punched 6 Wire wrapped 9 Drilled holes 10 Other (specify)

SCREEN-PERFORATED INTERVALS: From ... ft. to ... ft. From ... ft. to ... ft.
GRAVEL PACK INTERVALS: From ... ft. to ... ft. From ... ft. to ... ft.

6 GROUT MATERIAL: 1 Neat cement 2 Cement grout 3 Bentonite 4 Other
Grout Intervals: From ... ft. to ... ft. From ... ft. to ... ft. From ... ft. to ... ft.

What is the nearest source of possible contamination: 1 Septic tank 4 Lateral lines 7 Pit privy 10 Livestock pens 14 Abandoned water well
2 Sewer lines 5 Cess pool 8 Sewage lagoon 11 Fuel storage 15 Oil well/Gas well
3 Watertight sewer lines 6 Seepage pit 9 Feedyard 12 Fertilizer storage 16 Other (specify below)
13 Insecticide storage
Direction from well? How many feet?

Table with columns: FROM, TO, LITHOLOGIC LOG, FROM, TO, PLUGGING INTERVALS. Contains lithological descriptions from 0 to 35 feet depth.

7 CONTRACTOR'S OR LANDOWNER'S CERTIFICATION: This water well was (1) constructed, (2) reconstructed, or (3) plugged under my jurisdiction and was completed on (mo/day/year) 4/12/2007 and this record is true to the best of my knowledge and belief. Kansas Water Well Contractor's License No. 527 This Water Well Record was completed on (mo/day/yr) 4/18/2007 under the business name of GeoCore, Inc. by (signature) Dale K...