


1 LOCATION OF WATER WELL: County: Cloud	Fraction NE ¼ SE ¼ NW ¼	Section Number 4	Township Number T 6 S	Range Number R 3 E/W
---	-----------------------------------	----------------------------	---------------------------------	--------------------------------

Distance and direction from nearest town or city street address of well if located within city?
1302 Lincoln, Concordia

2 WATER WELL OWNER: **Mid-America Merchandising**
 RR#, St. Address, Box # : **204 W. Third**
 City, State, ZIP Code : **Kansas City, MO 64104**
 Board of Agriculture, Division of Water Resources
 Application Number:

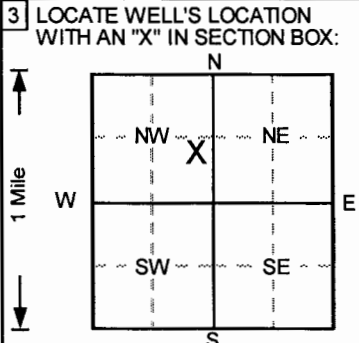

4 DEPTH OF COMPLETED WELL **35** ft. ELEVATION:

Depth(s) Groundwater Encountered 1. ft. 2. ft. 3. ft.

WELL'S STATIC WATER LEVEL ft. below land surface measured on mo/day/yr

Pump test data: Well water was **NA** ft. after hours pumping gpm

Est. Yield .. **NA** .. gpm: Well water was ft. after hours pumping gpm

Bore Hole Diameter **8** in. to **35** ft., and in. to ft.

WELL WATER TO BE USED AS: 5 Public water supply 8 Air conditioning 11 Injection well
 1 Domestic 3 Feedlot 6 Oil field water supply 9 Dewatering 12 Other (Specify below)
 2 Irrigation 4 Industrial 7 Lawn and garden only **10** Monitoring **الص**

Was a chemical/bacteriological sample submitted to Department? Yes.....No ..; If yes, mo/day/yr sample was submitted

Water Well Disinfected? Yes No

5 TYPE OF BLANK CASING USED:

1 Steel	3 RMP (SR)	6 Asbestos-Cement	9 Other (specify below)	Welded
2 PVC	4 ABS	7 Fiberglass		Threaded. <input checked="" type="checkbox"/>

Blank casing diameter **2** in. to **15** ft., Dia in. to ft., Dia in. to ft.

Casing height above land surface **0** in., weight lbs./ft. Wall thickness or gauge No. **Sch. 40**

TYPE OF SCREEN OR PERFORATION MATERIAL **7** PVC 10 Asbestos-cement

1 Steel	3 Stainless steel	5 Fiberglass	8 RMP (SR)	11 Other (specify)
2 Brass	4 Galvanized steel	6 Concrete tile	9 ABS	12 None used (open hole)

SCREEN OR PERFORATION OPENINGS ARE:

1 Continuous slot	3 Mill slot	5 Gauzed wrapped	8 Saw cut	11 None (open hole)
2 Louvered shutter	4 Key punched	6 Wire wrapped	9 Drilled holes	
		7 Torch cut	10 Other (specify)	

SCREEN-PERFORATED INTERVALS: From **15** ft. to **35** ft., From ft. to ft.

GRAVEL PACK INTERVALS: From **13** ft. to **35** ft., From ft. to ft.

6 GROUT MATERIAL: 1 Neat cement **2** Cement grout **3** Bentonite 4 Other

Grout intervals: From **0** ft. to **1** ft., From **1** ft. to **13** ft., From ft. to ft.

What is the nearest source of possible contamination:

1 Septic tank	4 Lateral lines	7 Pit privy	10 Livestock pens	14 Abandoned water well
2 Sewer lines	5 Cess pool	8 Sewage lagoon	11 Fuel storage	15 Oil well/Gas well
3 Watertight sewer lines	6 Seepage pit	9 Feedyard	12 Fertilizer storage	16 Other (specify below)
			13 Insecticide storage	

Direction from well? How many feet?

FROM	TO	LITHOLOGIC LOG	FROM	TO	PLUGGING INTERVALS
0	1	Clay, silty, v. moist, v. plastic, no odor, Dark B			
1	5	Clay, silty, moist, plastic, no odor, Brown			
5	8	Silt, sl. clayey, moist, no odor, Brown			
8	11	Clay, v. silty, moist, plastic, no odor, Brown			
11	21	Silt, sl.-mod. clayey, moist, no odor, Lt. Brown			
21	24	Clay, silty, v. moist, v. plastic, no odor, Brown			
24	30	Silt, sl. clayey, v. moist, no odor, Brown to Lt.			
30	35	Clay, silty, v. moist, v. plastic, no odor, Brown			
					MW9R , Tag # 0041394 , Flushmount
					Project Name: Rick's Concordia Apco - Monitoring
					GeoCore # 380 , KDHE # US 015 10020

7 CONTRACTOR'S OR LANDOWNER'S CERTIFICATION: This water well was **1** constructed, (2) reconstructed, or (3) plugged under my jurisdiction and was completed on (mo/day/year) **4/11/2007** and this record is true to the best of my knowledge and belief.

Kansas Water Well Contractor's License No. **527** This Water Well Record was completed on (mo/day/yr) **4/17/2007** under the business name of **GeoCore, Inc.** by (signature) *Dale Kelly*