


WATER WELL PLUGGING RECORD Form WWC-5P KSA 82a-1212 ID NO.

1 LOCATION OF WATER WELL: Fraction NE 1/4 NW 1/4 NW 1/4 NE 1/4 Section Number 5 Township Number T 6 S Range Number 3 E W
 County: Cloud
 Street/Rural Address of Well Location; if unknown, distance & direction from nearest town or intersection: If at owner's address, check here 830 W 11TH
Concordia, KS. 66901
Global Positioning Systems (GPS) information:
 Latitude: 39.565959 (in decimal degrees)
 Longitude: -97.674588 (in decimal degrees)
 Elevation: _____
 Horizontal Datum: WGS84, NAD83, NAD27
 Collection Method: _____

2 WATER WELL OWNER: City of Concordia
 RR#, St. Address, Box #: P.O. Box 603
 City, State ZIP Code: Concordia, KS. 66901
 GPS unit (Make/Model): _____
 Digital Map/Photo, Topographic Map, Land Survey
 Est. Accuracy: < 3 m, 3-5 m, 5-15 m, > 15 m

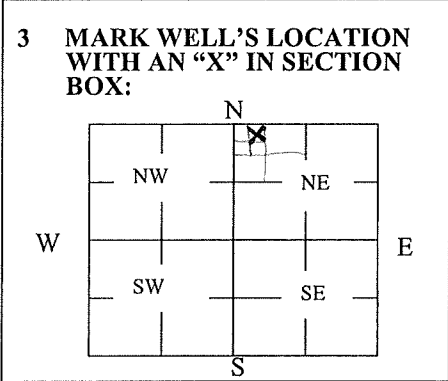

4 DEPTH OF WELL 80 ft.
 WELL'S STATIC WATER LEVEL < 60 ft.
 WELL WAS USED AS:
 Domestic Public Water Supply Dewatering
 Irrigation Oil Field Water Supply Monitoring
 Feedlot Domestic (Lawn & Garden) Injection Well
 Industrial Air Conditioning Other _____
 Was a chemical/bacteriological sample submitted to Department? Yes No

5 TYPE OF BLANK CASING USED:
 Steel RMP (SR) Wrought Fiberglass Other (Specify below)
 PVC ABS Asbestos-Cement Concrete Tile
 Blank casing diameter 6 in. Was casing pulled? Yes No If yes, how much 12-15'
 Casing height above or below land surface 240 in. below finish grade.

6 GROUT PLUG MATERIAL: Neat cement Cement grout Bentonite Other _____
 Grout Plug Intervals: From 80 ft. to 50 ft., From 55 ft. to 0 ft., From _____ ft. to _____ ft.
 What is the nearest source of possible contamination:
 Septic tank Seepage pit Fuel storage Other (specify below)
 Sewer lines Pit privy Fertilizer storage
 Watertight sewer lines Sewage lagoon Insecticide storage
 Lateral lines Feedyard Abandoned water well
 Cess pool Livestock pens Oil well/Gas well
 Direction from well? East
 How many feet? 500 feet

FROM	TO	PLUGGING MATERIALS	FROM	TO	PLUGGING MATERIALS
80'	55'	Clean disinfected gravel			Top of plug
55'	0'	Flowable neat cement			estimated to be
					20 feet below finish
		Well was in bottom			grade.
		of 15' feet deep pit.			
		Pit was demolished &			(240 inches)
		filled in.			

7 CONTRACTOR'S OR LANDOWNER'S CERTIFICATION: This water well was plugged under my jurisdiction and was completed on (mo/day/year) April 18/2024 and this record is true to the best of my knowledge and belief. Kansas Water Well Contractor's License No. N/A. This Water Well Record was completed on (mo/day/year) 5/21/24 under the business name of Smith Construction Services by (signature) [Signature]