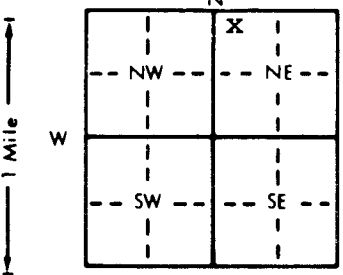


1 LOCATION OF WATER WELL: County: Cloud Fraction: NW 1/4 NW 1/4 NE 1/4 Section Number: 9 Township Number: T 6 S Range Number: R 3 **XNW**

Distance and direction from nearest town or city street address of well if located within city?
South of Concordia, Kansas

2 WATER WELL OWNER: City of Concordia
 RR#, St. Address, Box #: Lincoln & 6th St. Board of Agriculture, Division of Water Resources
 City, State, ZIP Code: Concordia, Kansas 66901 Application Number:

3 LOCATE WELL'S LOCATION WITH AN "X" IN SECTION BOX:

 4 DEPTH OF COMPLETED WELL: 111' BGL ft. ELEVATION: 1650
 Depth(s) Groundwater Encountered: 1. 57 ft. 2. _____ ft. 3. _____ ft.
 WELL'S STATIC WATER LEVEL: 57 ft. below land surface measured on mo/day/yr 7/8/90
 Pump test data: Well water was _____ ft. after _____ hours pumping _____ gpm
 Est. Yield: 150 gpm; Well water was 88.5 ft. after 20 hours pumping 150 gpm
 Bore Hole Diameter: 4.4 in. to 111 ft., and _____ in. to _____ ft.
 WELL WATER TO BE USED AS:
 5 Public water supply 8 Air conditioning 11 Injection well
 1 Domestic 3 Feedlot 6 Oil field water supply 9 Dewatering 12 Other (Specify below)
 2 Irrigation 4 Industrial 7 Lawn and garden only 10 Monitoring well
 Was a chemical/bacteriological sample submitted to Department? Yes _____ No _____ If yes, mo/day/yr sample was submitted _____
 Water Well Disinfected? Yes _____ No _____

5 TYPE OF BLANK CASING USED:
 1 Steel 3 RMP (SR) 5 Wrought iron 8 Concrete tile CASING JOINTS: Glued _____ Clamped _____
 2 PVC 4 ABS 6 Asbestos-Cement 9 Other (specify below) Welded X
 7 Fiberglass _____ Threaded _____
 Blank casing diameter: 12 in. to 75 ft., Dia _____ in. to _____ ft., Dia _____ in. to _____ ft.
 Casing height above land surface: 30 in., weight _____ lbs./ft. Wall thickness or gauge No. _____
 TYPE OF SCREEN OR PERFORATION MATERIAL:
 1 Steel 3 Stainless steel 5 Fiberglass 7 PVC 10 Asbestos-cement
 2 Brass 4 Galvanized steel 6 Concrete tile 8 RMP (SR) 11 Other (specify) _____
 9 ABS 12 None used (open hole)
 SCREEN OR PERFORATION OPENINGS ARE:
 5 Gauzed wrapped 8 Saw cut 11 None (open hole)
 1 Continuous slot 3 Mill slot 6 Wire wrapped 9 Drilled holes
 2 Louvered shutter 4 Key punched 7 Torch cut 10 Other (specify) _____
 SCREEN-PERFORATED INTERVALS: From 75 ft. to 108 ft., From _____ ft. to _____ ft.
 From _____ ft. to _____ ft., From _____ ft. to _____ ft.
 GRAVEL PACK INTERVALS: From 55 ft. to 111 ft., From _____ ft. to _____ ft.
 From _____ ft. to _____ ft., From _____ ft. to _____ ft.

6 GROUT MATERIAL: 1 Neat cement 2 Cement grout 3 Bentonite 4 Other _____
 Grout Intervals: From 55 ft. to 4 ft., From _____ ft. to _____ ft., From _____ ft. to _____ ft.
 What is the nearest source of possible contamination:
 1 Septic tank 4 Lateral lines 7 Pit privy 10 Livestock pens 14 Abandoned water well
 2 Sewer lines 5 Cess pool 8 Sewage lagoon 11 Fuel storage 15 Oil well/Gas well
 3 Watertight sewer lines 6 Seepage pit 9 Feedyard 12 Fertilizer storage 16 Other (specify below)
 13 Insecticide storage
 Direction from well? N.W. How many feet? approx. 100'

FROM	TO	LITHOLOGIC LOG	FROM	TO	PLUGGING INTERVALS
0	30	sandstone with clay streaks			
30	36	gray silty clay			
36	40	yellow silty clay			
40	60	gray silty clay			
60	69	sandstone with clay streaks			
69	111	sandstone, hard w/few streaks clay			

7 CONTRACTOR'S OR LANDOWNER'S CERTIFICATION: This water well was (1) constructed, (2) reconstructed, or (3) plugged under my jurisdiction and was completed on (mo/day/year) 7/8/90 and this record is true to the best of my knowledge and belief. Kansas Water Well Contractor's License No. 102 W This Water Well Record was completed on (mo/day/yr) 9/13/90 under the business name of Layne-Western Co., Inc., Wichita, Ks. by (signature) B. Meier

INSTRUCTIONS: Use typewriter or ball point pen. PLEASE PRESS FIRMLY and PRINT clearly. Please fill in blanks, underline or circle the correct answers. Send top three copies to Kansas Department of Health and Environment, Bureau of Water, Topeka, Kansas 66620-7320. Telephone: 913-296-5545. Send one to WATER WELL OWNER and retain one for your records.

22-9001230072