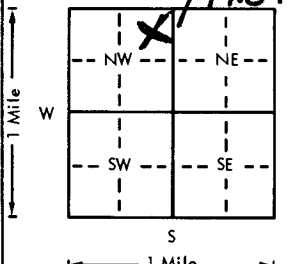
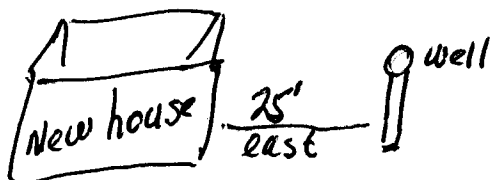


USE TYPEWRITER OR BALL  
POINT PEN-PRESS FIRMLY,  
PRINT CLEARLY.

WATER WELL RECORD  
KSA 82a-1201-1215

Kansas Department of Health and  
Environment-Division of Environment  
(Water well Contractors)  
Topeka, Kansas 66620

1. Location of well:	County <u>Cloud</u>	Fraction <u>NE 1/4 NE 1/4 NW 1/4</u>	Section number <u>10</u>	Township number <u>6</u>	Range number <u>3</u>	E <u>W</u>
2. Distance and direction from nearest town or city: <u>1/2 mile South of Concordia</u> Street address of well location if in city:			3. Owner of well: <u>Red CART</u> R.R. or street: <u>Rta 3</u> City, state, zip code: <u>Concordia, KANSAS 66901</u>			
4. Locate with "X" in section below <u>N 1/4 NE NW</u> 			Sketch map: 			
5. Type and color of material			From	To	6. Bore hole dia. <u>8 1/2</u> in. Completion date: <u>Apr. 14, 1977</u> Well depth <u>82</u> ft.	
<u>Black Soil</u>			<u>0</u>	<u>25</u>	7. <input checked="" type="checkbox"/> Cable tool <input checked="" type="checkbox"/> Rotary <input type="checkbox"/> Driven <input type="checkbox"/> Dug <input type="checkbox"/> Hollow rod <input type="checkbox"/> Jetted <input type="checkbox"/> Bored <input type="checkbox"/> Reverse rotary	
<u>Sandstone</u>			<u>25</u>	<u>45</u>	8. Use: <input checked="" type="checkbox"/> Domestic <input type="checkbox"/> Public supply <input type="checkbox"/> Industry <input type="checkbox"/> Irrigation <input type="checkbox"/> Air conditioning <input type="checkbox"/> Stock <input type="checkbox"/> Lawn <input type="checkbox"/> Oil field water <input type="checkbox"/> Other	
<u>Grey Clay</u>			<u>46</u>	<u>50</u>	9. Casing: Material <input type="checkbox"/> Height: Above or below Threaded <input type="checkbox"/> Welded <input type="checkbox"/> Surface <u>72</u> in. RMP <input type="checkbox"/> PVC <input checked="" type="checkbox"/> Weight <u>15</u> lbs./ft. Dia. <u>5</u> in. to <u>8 1/2</u> ft. depth Wall Thickness: <u>1/4</u> in. Dia. <u>5</u> in. to <u>8 1/2</u> ft. depth gage No. <u>14</u>	
<u>Sandstone</u>			<u>50</u>	<u>75</u>	10. Screen: Manufacturer's name <u>CANTEX</u> Type <u>100/164</u> Dia. <u>5</u> " Slot/gauze <u>10</u> " Length <u>10</u> " Set between <u>172</u> ft. and <u>82</u> ft. ft. and <u>14</u> ft. Gravel pack? <input checked="" type="checkbox"/> Size range of material <u>1/4</u>	
<u>Red clay -</u>			<u>75</u>	<u>82</u>	11. Static water level: <u>24</u> ft. below land surface Date <u>4/14/77</u> mo./day/yr.	
					12. Pumping level below land surfaces: <u>70</u> ft. after <u>1</u> hrs. pumping <u>6</u> g.p.m. <u>70</u> ft. after <u>  </u> hrs. pumping <u>  </u> g.p.m. Estimated maximum yield <u>12</u> g.p.m.	
					13. Water sample submitted: <input checked="" type="checkbox"/> Yes <input type="checkbox"/> No Date <u>4/17/77</u> mo./day/yr.	
					14. Well head completion: <u>No</u> Pitless adapter <u>  </u> inches above grade	
					15. Well grouted? <input checked="" type="checkbox"/> With: <input type="checkbox"/> Neat cement <input type="checkbox"/> Bentonite <input checked="" type="checkbox"/> Concrete Depth: From <u>3</u> ft. to <u>15</u> ft.	
					16. Nearest source of possible contamination: ft. <u>300</u> Direction <u>NORTH</u> Type <u>Creek</u> Well disinfected upon completion? <input type="checkbox"/> Yes <input type="checkbox"/> No	
					17. Pump: <u>No</u> Not installed Manufacturer's name <u>  </u> Model number <u>  </u> HP <u>  </u> Volts <u>  </u> Length of drop pipe <u>  </u> ft. capacity <u>  </u> g.p.m. Type: <input type="checkbox"/> Submersible <input type="checkbox"/> Turbine <input type="checkbox"/> Jet <input type="checkbox"/> Reciprocating <input type="checkbox"/> Centrifugal <input type="checkbox"/> Other	
			(Use a second sheet if needed)			
18. Elevation:  Topography: <input type="checkbox"/> Hill <input checked="" type="checkbox"/> Slope <input type="checkbox"/> Upland <input type="checkbox"/> Valley	19. Remarks:		20. Water well contractor's certification: This well was drilled under my jurisdiction and this report is true to the best of my knowledge and belief. <u>247</u> Business name <u>Art Thomas &amp; Son</u> License No. <u>333 E 16th St</u> Address <u>Topeka, KS</u> Date <u>6/8/77</u> Signature <u>Armer Thomas</u> Authorized representative			

Forward the white, blue and pink copies to the Department of Health and Environment

Form WWC-5