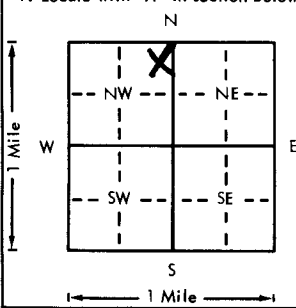


USE TYPEWRITER OR BALL POINT PEN-PRESS FIRMLY, PRINT CLEARLY.

WATER WELL RECORD
KSA 82a-1201-1215

Kansas Department of Health and Environment-Division of Environment (Water well Contractors) Topeka, Kansas 66620

1. Location of well:	County: Cloud	Fraction: NE NW <small>(1/4) 1/4 1/4</small>	Section number: 10	Township number: 6 <small>T 6 S R</small>	Range number: 3 <small>E/W</small>		
2. Distance and direction from nearest town or city: 1/2 mile South of Concordia <small>Street address of well location if in city:</small>			3. Owner of well: Bill Gropp R.R. or street: Rt 3 City, state, zip code: Concordia, Kansas 66901				
4. Locate with "X" in section below: 			Sketch map: Well is about 50' West of east fence line of property.				
5. Type and color of material			From	To	6. Bore hole dia: 8 1/2 in. Completion date: Mar. 24, 1977 Well depth: 82 ft.		
Black soil			0	25	7. Cable tool: <input checked="" type="checkbox"/> Rotary <input type="checkbox"/> Driven <input type="checkbox"/> Dug <input type="checkbox"/> Hollow rod <input type="checkbox"/> Jetted <input type="checkbox"/> Bored <input type="checkbox"/> Reverse rotary		
Sandstone			25	45	8. Use: <input checked="" type="checkbox"/> Domestic <input type="checkbox"/> Public supply <input type="checkbox"/> Industry <input type="checkbox"/> Irrigation <input type="checkbox"/> Air conditioning <input type="checkbox"/> Stock <input type="checkbox"/> Lawn <input type="checkbox"/> Oil field water <input type="checkbox"/> Other		
Grey Clay			46	50	9. Casing: Material _____ Height: Above or below Threaded _____ Welded _____ Surface 12 in. RMP _____ PVC <input checked="" type="checkbox"/> Weight 1/4 lbs./ft. Dia. 5 in. to 82 ft. depth Wall Thickness, inches or Dia. _____ in. to _____ ft. depth gage No. 1/4		
Sandstone			50	75	10. Screen: Manufacturer's name: CAN-TEX Type: 100/164 Dia. 5" Slot/gauze: 70/164 Length 12' Set between 70 ft. and 82 ft. Gravel pack? <input checked="" type="checkbox"/> Size range of material: 1/4 ft.		
Red Clay			75	82	11. Static water level: _____ ft. below land surface Date: 3/25/77 24 mo./day/yr.		
					12. Pumping level below land surfaces: 10 ft. after 1 hrs. pumping 8 g.p.m. _____ ft. after _____ hrs. pumping _____ g.p.m. Estimated maximum yield _____ g.p.m.		
					13. Water sample submitted: _____ mo./day/yr. <input checked="" type="checkbox"/> Yes <input type="checkbox"/> No Date: 3/25/77		
					14. Well head completion: <input type="checkbox"/> Pitless adapter 12 Inches above grade		
					15. Well grouted? <input checked="" type="checkbox"/> With: <input type="checkbox"/> Neap cement <input type="checkbox"/> Bentonite <input checked="" type="checkbox"/> Concrete Depth: From 10 ft. to 80 ft.		
					16. Nearest source of possible contamination: ft. 140 Direction West Type Septic Well disinfected upon completion? <input checked="" type="checkbox"/> Yes <input type="checkbox"/> No		
					17. Pump: <input checked="" type="checkbox"/> Not installed Manufacturer's name _____ Model number _____ HP _____ Volts _____ Length of drop pipe _____ ft. capacity _____ g.p.m. Type: <input type="checkbox"/> Submersible <input type="checkbox"/> Turbine <input type="checkbox"/> Jet <input type="checkbox"/> Reciprocating <input type="checkbox"/> Centrifugal <input type="checkbox"/> Other		
18. Elevation:			19. Remarks: Site for a trailer house			20. Water well contractor's certification: This well was drilled under my jurisdiction and this report is true to the best of my knowledge and belief. 3/24/77 Business name: Carl Thomas & Son License No. _____ Address: 333 E 16th Concordia, KS Signed: Carl Thomas Date: 3/24/77 Authorized representative	

Forward the white, blue and pink copies to the Department of Health and Environment

Form WWC-5