


Copy - 95

1 LOCATION OF WATER WELL: Fraction NE 1/4 SE 1/4 NW 1/4 Section Number 23 Township Number T 6 S Range Number R 3W E/W

Distance and direction from nearest town or city street address of well if located within city?
 2 M South, 2 M East, 1/2 M South of Concordia

2 WATER WELL OWNER: Cloud County Rural Water District #1
 RR#, St. Address, Box #: Box 286 Board of Agriculture, Division of Water Resources
 City, State, ZIP Code: Jamestown, Kansas 66948 Application Number: 35,452

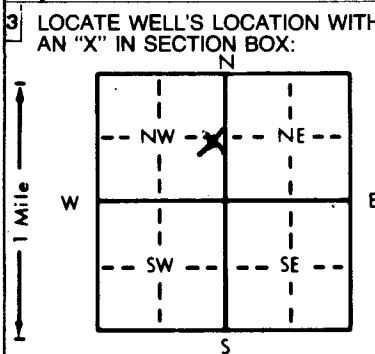

4 DEPTH OF COMPLETED WELL: 110' ft. ELEVATION: 1410
 Depth(s) Groundwater Encountered 1. 18' 59' ft. 2. 40' ft. 3. 9 - 10 - 81 ft.
 WELL'S STATIC WATER LEVEL 18' ft. below land surface measured on mo/day/yr 9 - 10 - 81
 Pump test data: Well water was 40' ft. after 6 hours pumping 131 gpm
 Est. Yield 500 gpm: Well water was ft. after hours pumping gpm
 Bore Hole Diameter 31" in. to 110' ft., and in. to ft.
 WELL WATER TO BE USED AS: X 5 Public water supply 8 Air conditioning 11 Injection well
 1 Domestic 3 Feedlot 6 Oil field water supply 9 Dewatering 12 Other (Specify below)
 2 Irrigation 4 Industrial 7 Lawn and garden only 10 Observation well
 Was a chemical/bacteriological sample submitted to Department? Yes No X NOT YES, mo/day/yr sample was submitted
 Water Well Disinfected? Yes X No

5 TYPE OF BLANK CASING USED: X 1 Steel 3 RMP (SR) 5 Wrought iron 8 Concrete tile CASING JOINTS: Glued Clamped
 2 PVC 4 ABS 6 Asbestos-Cement 9 Other (specify below) Welded X
 7 Fiberglass Threaded
 Blank casing diameter 10" in. to 90' ft., Dia. in. to ft., Dia. in. to ft.
 Casing height above land surface 18" in., weight 38# lbs./ft. Wall thickness or gauge No. 365
 TYPE OF SCREEN OR PERFORATION MATERIAL: 7 PVC 10 Asbestos-cement
 1 Steel X 3 Stainless steel 5 Fiberglass 8 RMP (SR) 11 Other (specify)
 2 Brass 4 Galvanized steel 6 Concrete tile 9 ABS 12 None used (open hole)
 SCREEN OR PERFORATION OPENINGS ARE: 5 Gauzed wrapped 8 Saw cut 11 None (open hole)
 1 Continuous slot 3 Mill slot X 6 Wire wrapped 9 Drilled holes
 2 Louvered shutter 4 Key punched 7 Torch cut 10 Other (specify)
 SCREEN-PERFORATED INTERVALS: From 90 ft. to 110' ft., From ft. to ft.
 From ft. to ft., From ft. to ft.
 GRAVEL PACK INTERVALS: From 83 ft. to 110' ft., From ft. to ft.
 From ft. to ft., From ft. to ft.

6 GROUT MATERIAL: 1 Neat cement X 2 Cement grout 3 Bentonite 4 Other
 Grout Intervals: From 4' ft. to 83' ft., From ft. to ft., From ft. to ft.
 What is the nearest source of possible contamination: NONE
 1 Septic tank 4 Lateral lines 7 Pit privy 10 Livestock pens 14 Abandoned water well
 2 Sewer lines 5 Cess pool 8 Sewage lagoon 11 Fuel storage 15 Oil well/Gas well
 3 Watertight sewer lines 6 Seepage pit 9 Feedyard 12 Fertilizer storage 16 Other (specify below)
 13 Insecticide storage
 Direction from well? How many feet?

FROM	TO	LITHOLOGIC LOG	FROM	TO	LITHOLOGIC LOG
0	20	Top Soil & Clay			
20	51	Clay			
51	64	Gravel			
64	66	Gravel & Clay			
66	79	Gravel			
79	80	Clay			
80	82	Sandrock			
82	83	Clay			
83	109	Sandrock			
109	110	Clay			

7 CONTRACTOR'S OR LANDOWNER'S CERTIFICATION: This water well was (1) constructed, (2) reconstructed, or (3) plugged under my jurisdiction and was completed on (mo/day/year) Sept. 10, 1981 and this record is true to the best of my knowledge and belief. Kansas Water Well Contractor's License No. 361 This Water Well Record was completed on (mo/day/yr) Sept. 17, 1981 under the business name of Cox-Beswick Irrigation Service, Inc. by (signature) Francis Cox

INSTRUCTIONS: Use typewriter or ball point pen, PLEASE PRESS FIRMLY and PRINT clearly. Please fill in blanks, underline or circle the correct answers. Send top three copies to Kansas Department of Health and Environment, Division of Environment, Environmental Geology Section, Topeka, KS 66620. Send one to WATER WELL OWNER and retain one for your records.

OFFICE USE ONLY

6
H
N
FW

SEC.
23
11/22/81