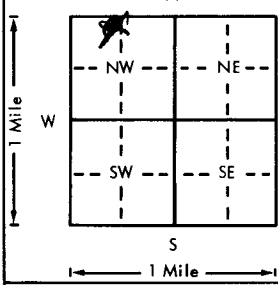


USE TYPEWRITER OR BALL POINT PEN—PRESS FIRMLY, PRINT CLEARLY.


WATER WELL RECORD
KSA 82a-1201-1215

Kansas Department of Health and Environment—Division of Environment
(Water well Contractors)
Topeka, Kansas 66620

1. Location of well: County <u>Cloud</u>		Fraction <u>NE @ NW 1/4 NW 1/4</u>		Section number <u>56</u>		Township number <u>T 6 S</u>		Range number <u>R 3 E @</u>	
2. Distance and direction from nearest town or city: <u>4 miles South of Concordia then 2 1/4 miles East on South side of road.</u>				3. Owner of well: <u>Robt GERING</u>					
Street address of well location if in city: <u>East on South side of road.</u>				R.R. or street: <u>Rfd. 3</u>					
City, state, zip code: <u>Concordia Kansas 66901</u>									
4. Locate with "X" in section below: N W E S 1 Mile 1 Mile				Sketch map: 					
5. Type and color of material				From		To			
<u>Black soil</u>				<u>0</u>		<u>30</u>			
<u>" " fine white rock</u>				<u>30</u>		<u>40</u>			
<u>Sand stone</u>				<u>40</u>		<u>45</u>			
<u>Clay-</u>				<u>46</u>		<u>49</u>			
<u>Sand stone</u>				<u>50</u>		<u>52</u>			
<u>Black shale</u>				<u>52</u>		<u>53</u>			
<u>Sand stone</u>				<u>53</u>		<u>69</u>			
<u>Grey CLAY-</u>				<u>70</u>		<u>90</u>			
<u>Sandstone</u>				<u>90</u>		<u>95</u>			
<u>Red CLAY</u>				<u>95</u>		<u>127</u>			
<u>SAND STONE</u>				<u>127</u>		<u>135</u>			
<u>Better Course SAND ROCK</u>				<u>136</u>		<u>156</u>			
(Use a second sheet if needed)									
18. Elevation: <u>~1450?</u>		19. Remarks:		20. Water well contractor's certification: This well was drilled under my jurisdiction and this report is true to the best of my knowledge and belief. <u>CARL THOMAN</u> <u>247</u> Business name: <u>SGT 128</u> License No.: <u>3/4 20</u> Address: <u>53 E 16th Concordia, KS</u> Signature: <u>Carl Thoman</u> Date: <u>3/17/77</u> Authorized representative					

Forward the white, blue and pink copies to the Department of Health and Environment

Form WWC-5

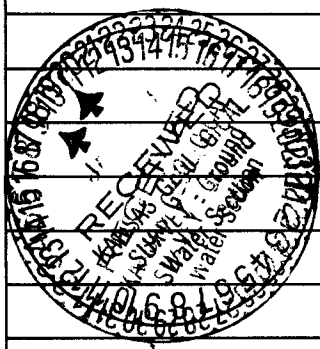

T
 6
 R
 2
 E
 2
 6
 NE NW NW
 1/4 1/4 1/4
 Sec