

WATER WELL RECORD Form WWC-5

Original Record Correction Change in Well Use


Division of Water Resources App. No.

49026

Well ID

1 LOCATION OF WATER WELL: County: **Thomas** Fraction: $\frac{1}{4}$ NW $\frac{1}{4}$ NW $\frac{1}{4}$ SW $\frac{1}{4}$ Section Number: **6** Township Number: **T 6 S** Range Number: **R 31** E W

2 WELL OWNER: Last Name: **Sloan** First: **Tom** Street or Rural Address where well is located (if unknown, distance and direction from nearest town or intersection): If at owner's address, check here:
 Business: Address: **545 Woofter Ave** **Rexford-6.5N, 5W, approx 1/2S, East Side**
 Address: City: **Colby** State: **KS** ZIP: **67701**

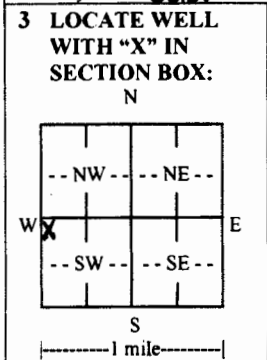

4 DEPTH OF COMPLETED WELL: **210** ft.
 Depth(s) Groundwater Encountered: 1) ft.
 2) ft. 3) ft. or 4) Dry Well
WELL'S STATIC WATER LEVEL: ft.
 below land surface, measured on (mo-day-yr).....
 above land surface, measured on (mo-day-yr).....
 Pump test data: Well water was ft.
 after hours pumping gpm
 Well water was ft.
 after hours pumping gpm
 Estimated Yield: **100+** gpm
 Bore Hole Diameter: **15** in. to **213** ft. and
 in. to ft.

5 Latitude: **39.56040** (decimal degrees)
Longitude: **100.83069** (decimal degrees)
Horizontal Datum: WGS 84 NAD 83 NAD 27
Source for Latitude/Longitude:
 GPS (unit make/model: **Garmin 650T**)
 (WAAS enabled? Yes No)
 Land Survey Topographic Map
 Online Mapper:

6 Elevation: ft. Ground Level TOC
Source: Land Survey GPS Topographic Map
 Other

7 WELL WATER TO BE USED AS:

1. Domestic: Household Lawn & Garden Livestock
 Irrigation
 Feedlot
 Industrial

2. Public Water Supply: well ID

3. Dewatering: how many wells?

4. Aquifer Recharge: well ID

5. Monitoring: well ID

6. Environmental Remediation: well ID

7. Air Sparge Soil Vapor Extraction

8. Recovery Injection

9. Oil Field Water Supply: lease

10. Test Hole: well ID

11. Cased Uncased Geotechnical

12. Geothermal: how many bores?

a) Closed Loop Horizontal Vertical

b) Open Loop Surface Discharge Inj. of Water

13. Other (specify):

Was a chemical/bacteriological sample submitted to KDHE? Yes No If yes, date sample was submitted:

Water well disinfected? Yes No

8 TYPE OF CASING USED: Steel PVC Other CASING JOINTS: Glued Clamped Welded Threaded
 Casing diameter **8** in. to **210** ft., Diameter in. to ft., Diameter in. to ft.
 Casing height above land surface **18** in. Weight **5.82** lbs./ft. Wall thickness or gauge No. **0.332**

TYPE OF SCREEN OR PERFORATION MATERIAL:
 Steel Stainless Steel Fiberglass PVC Other (Specify)

Brass Galvanized Steel Concrete tile None used (open hole)

SCREEN OR PERFORATION OPENINGS ARE:
 Continuous Slot Mill Slot Gauze Wrapped Torch Cut Drilled Holes Other (Specify)

Louvered Shutter Key Punched Wire Wrapped Saw Cut None (Open Hole)

SCREEN-PERFORATED INTERVALS: From **130** ft. to **210** ft., From ft. to ft., From ft. to ft.

GRAVEL PACK INTERVALS: From **20** ft. to **210** ft., From ft. to ft., From ft. to ft.

9 GROUT MATERIAL: Neat cement Cement grout Bentonite Other

Grout Intervals: From **0** ft. to **20** ft., From ft. to ft., From ft. to ft.

Nearest source of possible contamination:
 Septic Tank Lateral Lines Pit Privy Livestock Pens Insecticide Storage
 Sewer Lines Cess Pool Sewage Lagoon Fuel Storage Abandoned Water Well
 Watertight Sewer Lines Seepage Pit Feedyard Fertilizer Storage Oil Well/Gas Well
 Other (Specify)

Direction from well? Distance from well? ft.

10 FROM	TO	LITHOLOGIC LOG	FROM	TO	LITHO. LOG (cont.) or PLUGGING INTERVALS
0	2	Surface	110	123	clay w/ sandstone
2	20	Loess	123	126	fine to med sand and gravel
20	37	Clay	126	143	clay w/ sand layers
37	50	sand w/ clay strks	143	161	sandstone and caliche
50	61	sandstone	161	170	fine sand
61	67	fine to med sand and gravel	170	175	clay
67	73	fine sand w/ clay strks	Notes:		
73	88	clay			
88	110	fine to med sand			

11 CONTRACTOR'S OR LANDOWNER'S CERTIFICATION: This water well was constructed, reconstructed, or plugged under my jurisdiction and was completed on (mo-day-year) **3-25-16** and this record is true to the best of my knowledge and belief. Kansas Water Well Contractor's License No. **838** This Water Well Record was completed on (mo-day-year) **4-21-16** under the business name of **RMD Drilling & Well Service, LLC** Signature: *[Signature]*

Mail 1 white copy along with a fee of \$5.00 for each constructed well to: Kansas Department of Health and Environment, Bureau of Water, GWTS Section, 1000 SW Jackson St., Suite 420, Topeka, Kansas 66612-1367. Mail one to Water Well Owner and retain one for your records. Telephone 785-296-5524. Visit us at <http://www.kdheks.gov/waterwell/index.html> **KSA 82a-1212** **Revised 7/10/2015**

