

WATER WELL PLUGGING RECORD Form WWC-5P

KSA 82a-1212


ID NO.

299

1 **LOCATION OF WATER WELL:** Fraction NE 1/4 SW 1/4 NW 1/4 NW 1/4 Section Number 16 Township Number T 0 S Range Number 52 E W
 County: Thomas

Street/Rural Address of Well Location; if unknown, distance & direction from nearest town or intersection: If at owner's address, check here 2704 County Road CC Cem, KS 67734
Global Positioning Systems (GPS) information:
 Latitude: 39.53770 (in decimal degrees)
 Longitude: 100.90495 (in decimal degrees)
 Elevation: _____
 Horizontal Datum: WGS84, NAD83, NAD27
 Collection Method: _____

2 **WATER WELL OWNER:** Bremen Pump Farms LP
 RR#, St. Address, Box #: 1546 County Road 23
 City, State ZIP Code: Colby, KS 67701
 GPS unit (Make/Model: Garmin E Trex 10)
 Digital Map/Photo, Topographic Map, Land Survey
 Est. Accuracy: <3 m, 3-5 m, 5-15 m, >15 m

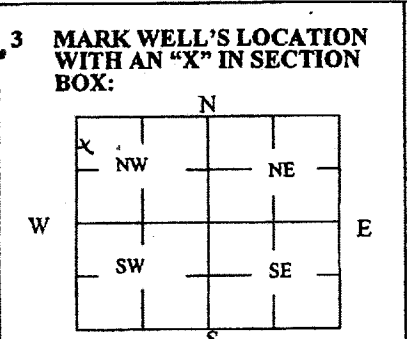

4 **DEPTH OF WELL** 50 ft.
WELL'S STATIC WATER LEVEL 35 ft.
WELL WAS USED AS:
 Domestic Public Water Supply Dewatering
 Irrigation Oil Field Water Supply Monitoring
 Feedlot Domestic (Lawn & Garden) Injection Well
 Industrial Air Conditioning Other _____
 Was a chemical/bacteriological sample submitted to Department? Yes No

5 **TYPE OF BLANK CASING USED:**
 Steel RMP (SR) Wrought Fiberglass Other (Specify below)
 PVC ABS Asbestos-Cement Concrete Tile
 Blank casing diameter 5" in. Was casing pulled? Yes No If yes, how much _____
 Casing height above of below land surface 60 in.

6 **GROUT PLUG MATERIAL:** Neat cement Cement grout Bentonite Other _____
 Grout Plug Intervals: From 29 ft. to 22 ft., From 15 ft. to 8 ft., From 8 ft. to 5 ft.
Bentonite Bentonite Cement Grout
 What is the nearest source of possible contamination:
 Septic tank Seepage pit Fuel storage Other (specify below)
 Sewer lines Pit privy Fertilizer storage
 Watertight sewer lines Sewage lagoon Insecticide storage
 Lateral lines Feedyard Abandoned water well
 Cess pool Livestock pens Oil well/Gas well
 Direction from well? W
 How many feet? 50

FROM	TO	PLUGGING MATERIALS	FROM	TO	PLUGGING MATERIALS
50	29	washed sand			
29	22	Bentonite			
22	15	clay			
15	8	Bentonite			
8	5	Cement - Grout			
5	0	compacted clay & topsoil			

7 **CONTRACTOR'S OR LANDOWNER'S CERTIFICATION:** This water well was plugged under my jurisdiction and was completed on (mo/day/year) 12-16-17 and this record is true to the best of my knowledge and belief. Kansas Water Well Contractor's License No. 6663. This Water Well Record was completed on (mo/day/year) 12-18-17 under the business name of Bremen Pump & Supply by (signature) [Signature]

Send one white copy to Kansas Department of Health & Environment, Geology Section, 1000 SW Jackson Street, Ste. 420, Topeka, KS 66612-1367. Send one copy to WATER WELL OWNER and retain one for your records.
 Visit us at <http://www.kdheks.gov/waterwell/index.html> Telephone 785-296-5524.