WATER WELL PLUGGING RECORD **Form WWC-5P** **KSA 82a-1212** **ID NO.** 300

1 LOCATION OF WATER WELL: County: Thomas	Fraction: SW ¼ NW ¼ NW ¼ NW ¼	Section Number: 16	Township Number: T 6 S	Range Number: 32 ☐ E ☒ W

Street/Rural Address of Well Location; if unknown, distance & direction from nearest town or intersection: If at owner's address, check here ☐ 2704 County Road CC, Gem, KS 67734

Global Positioning Systems (GPS) information:
Latitude: 39.53793 (in decimal degrees)
Longitude: 100.90502 (in decimal degrees)
Elevation:
Horizontal Datum: ☐ WGS84, ☐ NAD83, ☐ NAD27
Collection Method:
☐ GPS unit (Make/Model: Garmin ETrex 10
☐ Digital Map/Photo, ☐ Topographic Map, ☐ Land Survey
Est. Accuracy: ☐ <3 m, ☐ 3-5 m, ☐ 5-15 m, ☐ >15 m

2 WATER WELL OWNER: Bremenkamp Farms LP
RR#, St. Address, Box #: 1546 County Road 23
City, State ZIP Code: Colby, KS 67701

3 MARK WELL'S LOCATION WITH AN "X" IN SECTION BOX:

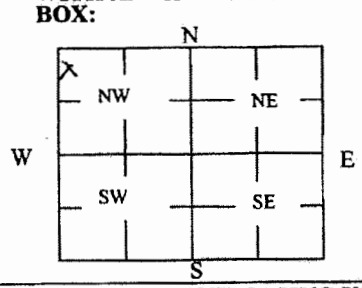

4 DEPTH OF WELL 90' ft.
WELL'S STATIC WATER LEVEL 30' ft
WELL WAS USED AS:

☒ Domestic ☐ Irrigation ☐ Feedlot ☐ Industrial
☐ Public Water Supply ☐ Oil Field Water Supply ☐ Domestic (Lawn & Garden) ☐ Air Conditioning
☐ Dewatering ☐ Monitoring ☐ Injection Well ☐ Other

Was a chemical/bacteriological sample submitted to Department? Yes ☐ No ☒

5 TYPE OF BLANK CASING USED:

☐ Steel ☒ PVC ☐ RMP (SR) ☐ ABS ☐ Wrought ☐ Asbestos-Cement ☐ Fiberglass ☐ Concrete Tile ☐ Other (Specify below)

Blank casing diameter 5" in. Was casing pulled? Yes ☐ No ☒ If yes, how much
Casing height above or (below) land surface 84 in.

6 GROUT PLUG MATERIAL: ☐ Neat cement ☒ Cement grout ☒ Bentonite ☐ Other

Grout Plug Intervals: From 25 ft. to 18 ft., Bentonite; From 13 ft. to 7 ft., Bentonite; From 7 ft. to 6 ft., Cement Grout Cap.

What is the nearest source of possible contamination:
☐ Septic tank ☐ Sewer lines ☐ Watertight sewer lines ☐ Lateral lines ☐ Cess pool
☐ Seepage pit ☐ Pit privy ☐ Sewage lagoon ☐ Feedyard ☒ Livestock pens
☐ Fuel storage ☐ Fertilizer storage ☐ Insecticide storage ☐ Abandoned water well ☐ Oil well/Gas well
☐ Other (specify below)
Direction from well? West
How many feet? 50'

FROM	TO	PLUGGING MATERIALS	FROM	TO	PLUGGING MATERIALS
90	25	washed Sand			
25	18	Bentonite			
18	13	Clay			
13	7	Bentonite			
7	6	Cement Grout			
6	0	Compacted Clay & Topsoil			

7 CONTRACTOR'S OR LANDOWNER'S CERTIFICATION: This water well was plugged under my jurisdiction and was completed on (mo/day/year) 12-16-17 and this record is true to the best of my knowledge and belief. Kansas Water Well Contractor's License No. 463. This Water Well Record was completed on (mo/day/year) 12-18-17 under the business name of Brenn Pump & Supply by (signature)

Send one white copy to Kansas Department of Health & Environment, Geology Section, 1000 SW Jackson Street, Ste. 420, Topeka, KS 66612-1367. Send one copy to WATER WELL OWNER and retain one for your records.
Visit us at http://www.kdheks.gov/waterwell/index.html Telephone 785-296-5524.