WATER WELL PLUGGING RECORD **Form WWC-5P** **KSA 82a-1212** **ID NO.**

1 **LOCATION OF WATER WELL:** County: Sherman	Fraction ¼ SW ¼ SE ¼ NW ¼	Section Number 33	Township Number T 6 S	Range Number 38 ☐ E ☑ W

Street/Rural Address of Well Location; if unknown, distance & direction from nearest town or intersection: If at owner's address, check here ☐

Rd 28.5 miles W of Edson,9.5 miles N,.5 mile W, N into .5 mi

Global Positioning Systems (GPS) information:
Latitude: 39.4902141 (in decimal degrees)
Longitude: -101.5708181 (in decimal degrees)
Elevation: 3542
Datum: ☐ WGS84, ☐ NAD83, ☐ NAD27
Collection Method:
☐ GPS unit (Make/Model: ____
☐ Digital Map/Photo, ☐ Topographic Map, ☐ Land Survey
Est. Accuracy: ☐ < 3 m, ☐ 3-5 m, ☐ 5-15 m, ☐ > 15 m

2 **WATER WELL OWNER:** Blake Flanders
RR#, St. Address, Box #: 5836 SW Turnberry Ct
City, State ZIP Code: Topeka, KS 66614

3 **MARK WELL'S LOCATION WITH AN "X" IN SECTION BOX:**

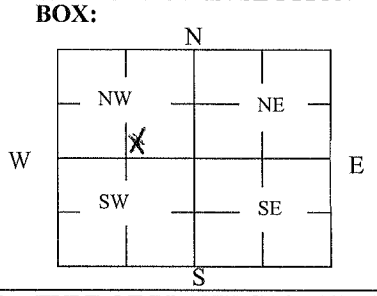

4 **DEPTH OF WELL** 320 ft.
WELL'S STATIC WATER LEVEL N/A ft
WELL WAS USED AS:

☐ Domestic ☐ Public Water Supply ☐ Dewatering
☐ Irrigation ☑ Oil Field Water Supply ☐ Monitoring
☐ Feedlot ☐ Domestic (Lawn & Garden) ☐ Injection Well
☐ Industrial ☐ Air Conditioning ☐ Other ____

Was a chemical/bacteriological sample submitted to Department? Yes ☐ No ☑

5 **TYPE OF BLANK CASING USED:**

☐ Steel ☐ RMP (SR) ☐ Wrought ☐ Fiberglass ☐ Other (Specify below)
☑ PVC ☐ ABS ☐ Asbestos-Cement ☐ Concrete Tile

Blank casing diameter 4.5 in. Was casing pulled? Yes ☐ No ☑ If yes, how much ____
Casing height above or below land surface 36 in.

6 **GROUT PLUG MATERIAL:** ☑ Neat cement ☐ Cement grout ☐ Bentonite ☐ Other ____

Grout Plug Intervals: From 320 ft. to 0 ft., From ____ ft. to ____ ft., From ____ to ____ ft.

What is the nearest source of possible contamination:

☐ Septic tank ☐ Seepage pit ☐ Fuel Storage ☑ Other (specify below)
☐ Sewer lines ☐ Pit privy ☐ Fertilizer storage none
☐ Watertight sewer lines ☐ Sewage lagoon ☐ Insecticide storage
☐ Lateral lines ☐ Feedyard ☐ Abandoned water well Direction from well? ____
☐ Cess pool ☐ Livestock pens ☐ Oil well/Gas well How many feet? ____

FROM	TO	PLUGGING MATERIALS	FROM	TO	PLUGGING MATERIALS
320'	0'	25 sks of Neat Cement w/			
		1 sk cotton seed hulls			

7 **CONTRACTOR'S OR LANDOWNER'S CERTIFICATION:** This water well was plugged under my jurisdiction and was completed on (mo/day/year) 9/21/2011 and this record is true to the best of my knowledge and belief. Kansas Water Well Contractor's License No. ____. This Water Well Record was completed on (mo/day/year) 9/23/2011 under the business name of Rosewood Resources, Inc. by (signature) Wayne Parker

INSTRUCTIONS: Use typewriter or ballpoint pen. Please press firmly and print clearly. Please fill in blanks, underline or circle the correct answers. Send top three copies to Kansas Department of Health and Environment, Bureau of Water, Geology Section, 1000 SW Jackson St., Ste. 420, Topeka, Kansas 66612-1367. Telephone: 785/296-5524. Send one to Water Well Owner and retain one for your records. Visit us at http://www.kdheks.gov/waterwell/index.html.

Check one: ☑ White Copy ☐ Blue Copy ☐ Pink Copy