

# WATER WELL RECORD Form WWC-5


*Corrected*

Division of Water Resources App. No.  Well ID

Original Record  Correction  Change in Well Use

**1 LOCATION OF WATER WELL:** Fraction SW 1/4 SW 1/4 NE 1/4 SW 1/4 Section Number 4 Township Number T 6 S Range Number R 4  E  W  
County: CLOUD

**2 WELL OWNER:** Last Name: JUDY REEDY First:  Street or Rural Address where well is located (if unknown, distance and direction from nearest town or intersection): If at owner's address, check here:   
Business: JUDY REEDY Address: 1907 N 200TH ROAD  
Address: 5 MILES WEST ON ROCK ROAD AND 3/4 MILE SOUTH ON 80TH ROAD  
City: CONCORDIA State: KS ZIP: 66901

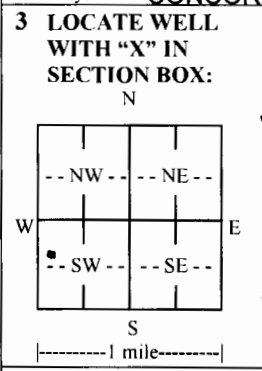

**4 DEPTH OF COMPLETED WELL:** 210 ft.  
Depth(s) Groundwater Encountered: 1) ..... ft.  
2) ..... ft. 3) ..... ft. or 4)  Dry Well  
WELL'S STATIC WATER LEVEL: ..... ft.  
 below land surface, measured on (mo-day-yr) .....  
 above land surface, measured on (mo-day-yr) .....  
Pump test data: Well water was ..... ft.  
after ..... hours pumping ..... gpm  
Well water was ..... ft.  
after ..... hours pumping ..... gpm  
Estimated Yield: 1200 gpm  
Bore Hole Diameter: 28 in. to 210 ft. and  
..... in. to ..... ft.

**5 Latitude:** 39.557721 ..... (decimal degrees)  
**Longitude:** -97.773746 ..... (decimal degrees)  
Horizontal Datum:  WGS 84  NAD 83  NAD 27  
Source for Latitude/Longitude: GARMIN  
 GPS (unit make/model: ..... (WAAS enabled?  Yes  No)  
 Land Survey  Topographic Map  
 Online Mapper: .....

**6 Elevation:** 1454 ..... ft.  Ground Level  TOC  
Source:  Land Survey  GPS  Topographic Map  
 Other GOOGLE EARTH .....

**7 WELL WATER TO BE USED AS:**

1. Domestic:  Household  Lawn & Garden  Livestock  
2.  Irrigation  
3.  Feedlot  
4.  Industrial  
5.  Public Water Supply: well ID .....  
6.  Dewatering: how many wells? .....  
7.  Aquifer Recharge: well ID .....  
8.  Monitoring: well ID .....  
9. Environmental Remediation: well ID .....  
 Air Sparge  Soil Vapor Extraction  
 Recovery  Injection  
10.  Oil Field Water Supply: lease .....  
11. Test Hole: well ID .....  
 Cased  Uncased  Geotechnical  
12. Geothermal: how many bores? .....  
a) Closed Loop  Horizontal  Vertical  
b) Open Loop  Surface Discharge  Inj. of Water  
13.  Other (specify): .....

Was a chemical/bacteriological sample submitted to KDHE?  Yes  No If yes, date sample was submitted: .....  
Water well disinfected? Yes  No

**8 TYPE OF CASING USED:**  Steel  PVC  Other ..... CASING JOINTS:  Glued  Clamped  Welded  Threaded  
Casing diameter 8 in. to 110 ft., Diameter ..... in. to ..... ft., Diameter ..... in. to ..... ft.  
Casing height above land surface 12 in. Weight 5.697 lbs./ft. Wall thickness or gauge No. 332 .....

TYPE OF SCREEN OR PERFORATION MATERIAL:  
 Steel  Stainless Steel  Fiberglass  PVC  Other (Specify) .....  
 Brass  Galvanized Steel  Concrete tile  None used (open hole)

SCREEN OR PERFORATION OPENINGS ARE:  
 Continuous Slot  Mill Slot  Gauze Wrapped  Torch Cut  Drilled Holes  Other (Specify) .....  
 Louvered Shutter  Key Punched  Wire Wrapped  Saw Cut  None (Open Hole)

SCREEN-PERFORATED INTERVALS: From 110 ft. to 210 ft., From ..... ft. to ..... ft., From ..... ft. to ..... ft.  
 GRAVEL PACK INTERVALS: From 30 ft. to 210 ft., From ..... ft. to ..... ft., From ..... ft. to ..... ft.

**9 GROUT MATERIAL:**  Neat cement  Cement grout  Bentonite  Other .....  
Grout Intervals: From 0 ft. to 30 ft., From ..... ft. to ..... ft., From ..... ft. to ..... ft.

Nearest source of possible contamination:  
 Septic Tank  Lateral Lines  Pit Privy  Livestock Pens  Insecticide Storage  
 Sewer Lines  Cess Pool  Sewage Lagoon  Fuel Storage  Abandoned Water Well  
 Watertight Sewer Lines  Seepage Pit  Feedyard  Fertilizer Storage  Oil Well/Gas Well  
 Other (Specify) None .....  
Direction from well? ..... Distance from well? ..... ft.

10 FROM	TO	LITHOLOGIC LOG	FROM	TO	LITHO. LOG (cont.) or PLUGGING INTERVALS
0	5	TOP SOIL			
5	27	TAN CLAY			
27	31	SAND ROCK			
31	118	GRAY CLAY			
118	144	WHITE SAND STONE - HARD			
144	154	GRAY CLAY			
154	211	WHITE SAND STONE - HARD			

Notes: **Original Returned to Sender for Correction Date: 8/1/17**

**11 CONTRACTOR'S OR LANDOWNER'S CERTIFICATION:** This water well was  constructed,  reconstructed, or  plugged under my jurisdiction and was completed on (mo-day-year) 08/18/2016 and this record is true to the best of my knowledge and belief. Kansas Water Well Contractor's License No. 480 This Water Well Record was completed on (mo-day-year) 12/07/2016 under the business name of WILLIAMS DRILLING CO., INC. Signature Ron Williams