USE TYPEWRITER OR BALL POINT PEN-PRESS FIRMLY, PRINT CLEARLY.

WATER WELL RECORD
KSA 82a-1201-1215

Kansas Department of Health and Environment-Division of Environment
(Water well Contractors)
Topeka, Kansas 66620

NW NW NE NE

1. Location of well:	County: Cloud	Fraction: 1/4 NE 1/4	Section number: 3	Township number: T 6 S	Range number: R 4 E/W

2. Distance and direction from nearest town or city: 5 miles W of Concordia on Parrell.
Street address of well location if in city:

3. Owner of well: WINNIE G. KROHN
R.R. or street: 714 WASHINGTON
City, state, zip code: CONCORDIA, KANSAS 66901

4. Locate with "X" in section below:

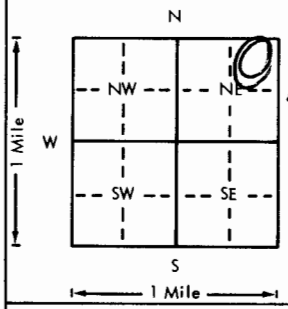

Sketch map:

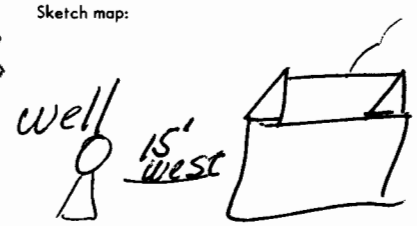

6. Bore hole dia. 8 in. Completion date Aug. 30 1976
Well depth 72 ft.

7. __ Cable tool ✓ Rotary __ Driven __ Dug
__ Hollow rod __ Jetted __ Bored __ Reverse rotary

8. Use: ✓ Domestic __ Public supply __ Industry
__ Irrigation __ Air conditioning __ Stock
__ Lawn __ Oil field water __ Other

9. Casing: Material _____ Height: Above or below
Threaded ____ Welded ____ Surface 12" in.
RMP ____ PVC ✓ Weight _____ lbs./ft.
Dia. 5" in. to 72 ft. depth Wall Thickness, inches or
Dia. ____ in. to ____ ft. depth gage No. 1/4

5. Type and color of material	From	To
Black Soil	0	15
Black soil & white fine rock	15	33
Red CLAY	33	62
SAND STONE -	62	72
CLAY -		

(Use a second sheet if needed)

10. Screen: Manufacturer's name Jetstream
Type 160 Dia. 5"
Slot/gauze 164 Length 20'
Set between 52 ft. and 72 ft.
____ ft. and ____ ft.
Gravel pack? ✓ Size range of material 1/4

11. Static water level:
30 ft. below land surface Date Sept 2, 1976

12. Pumping level below land surfaces:
45 ft. after 1 hrs. pumping 10 g.p.m.
____ ft. after ____ hrs. pumping ____ g.p.m.
Estimated maximum yield 15 g.p.m.

13. Water sample submitted:
✓ Yes ____ No Date Sept. 3, 1976

14. Well head completion:
NO pitless adapter 12" Inches above grade

15. Well grouted? ✓
With: ____ Neat cement ____ Bentonite ✓ Concrete
Depth: From 1 ft. to 16 ft.

16. Nearest source of possible contamination:
ft. 200 Direction East Type Septic
Well disinfected upon completion? ✓ Yes ____ No

17. Pump: ✓ Not installed
Manufacturer's name
Model number ____ HP ____ Volts ____
Length of drop pipe ____ ft. capacity ____ g.p.m.
Type:
__ Submersible __ Turbine
✓ Jet __ Reciprocating
__ Centrifugal __ Other

18. Elevation: ~1110
Topography:
__ Hill
__ Slope
✓ Upland
__ Valley

19. Remarks:

20. Water well contractor's certification:
This well was drilled under my jurisdiction and this report is true to the best of my knowledge and belief.
Carl Thomason 247
Business name License No.
333 E 16th Concordia KS
Address
Signed James Thomason Date 9/18/76
Authorized representative

T 6 R 4 E/W Sec 3 NE 1/4 1/4 1/4 1/4

Forward the white, blue and pink copies to the Department of Health and Environment

Form WWC-5

MI-1023